




REV Peck
Details
1201
Sheet A10 of 11

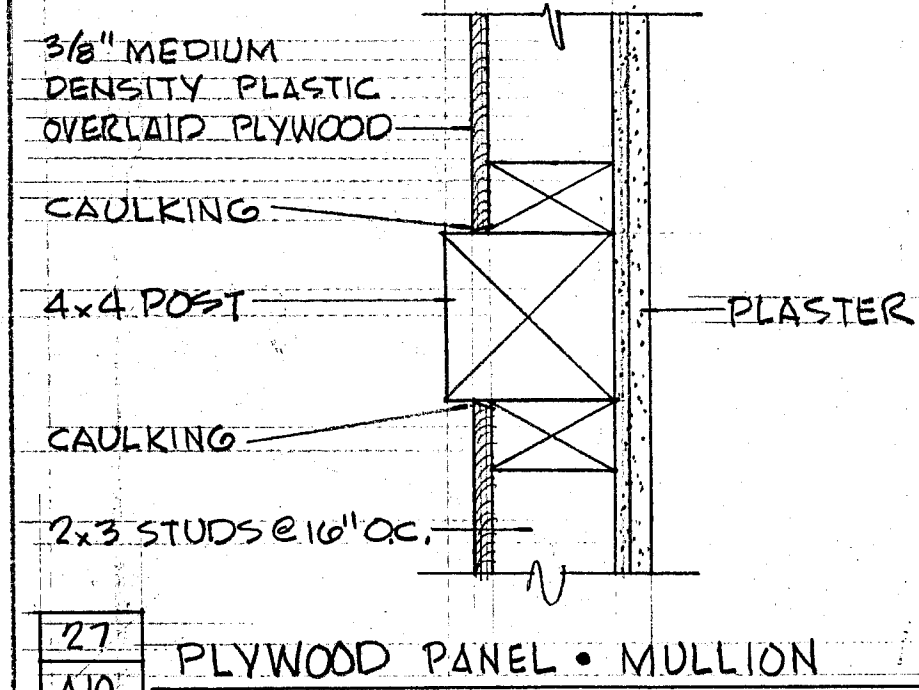


27
A10 PLYWOOD PANEL • MULLION

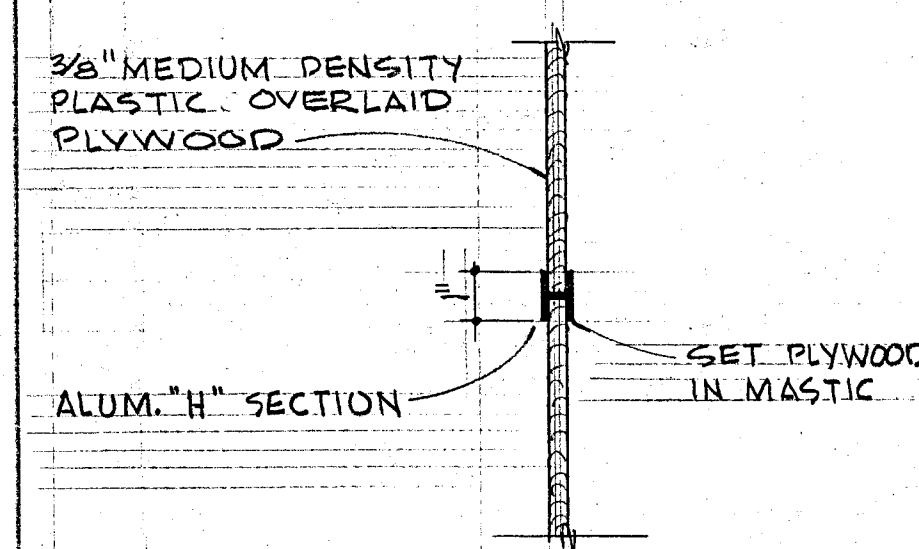


28
A10 PLYWOOD PANEL • MUNTIN

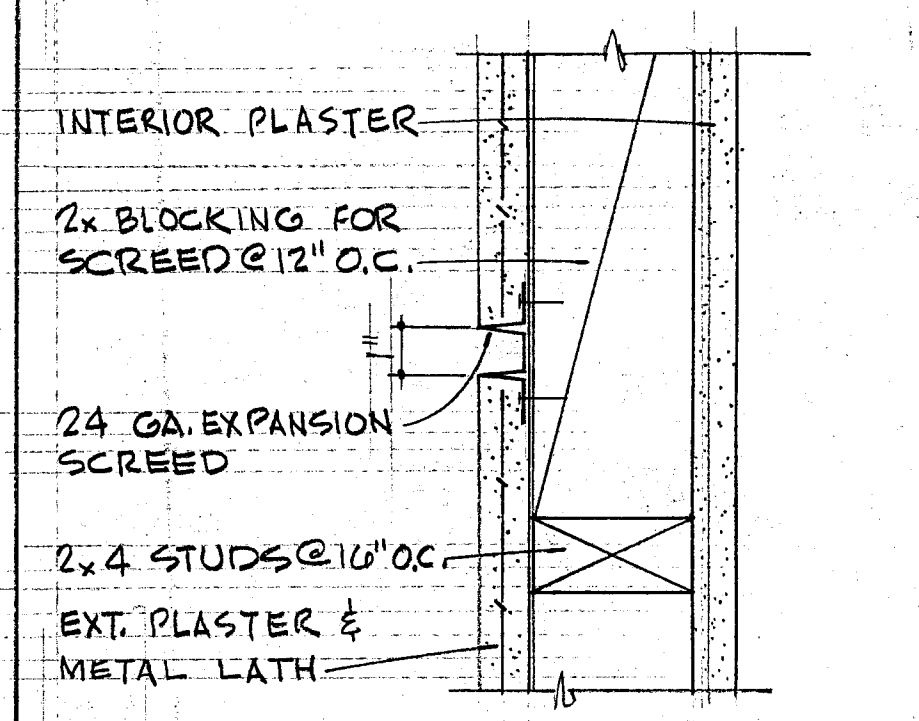


29
A10 EXPANSION CHANNEL

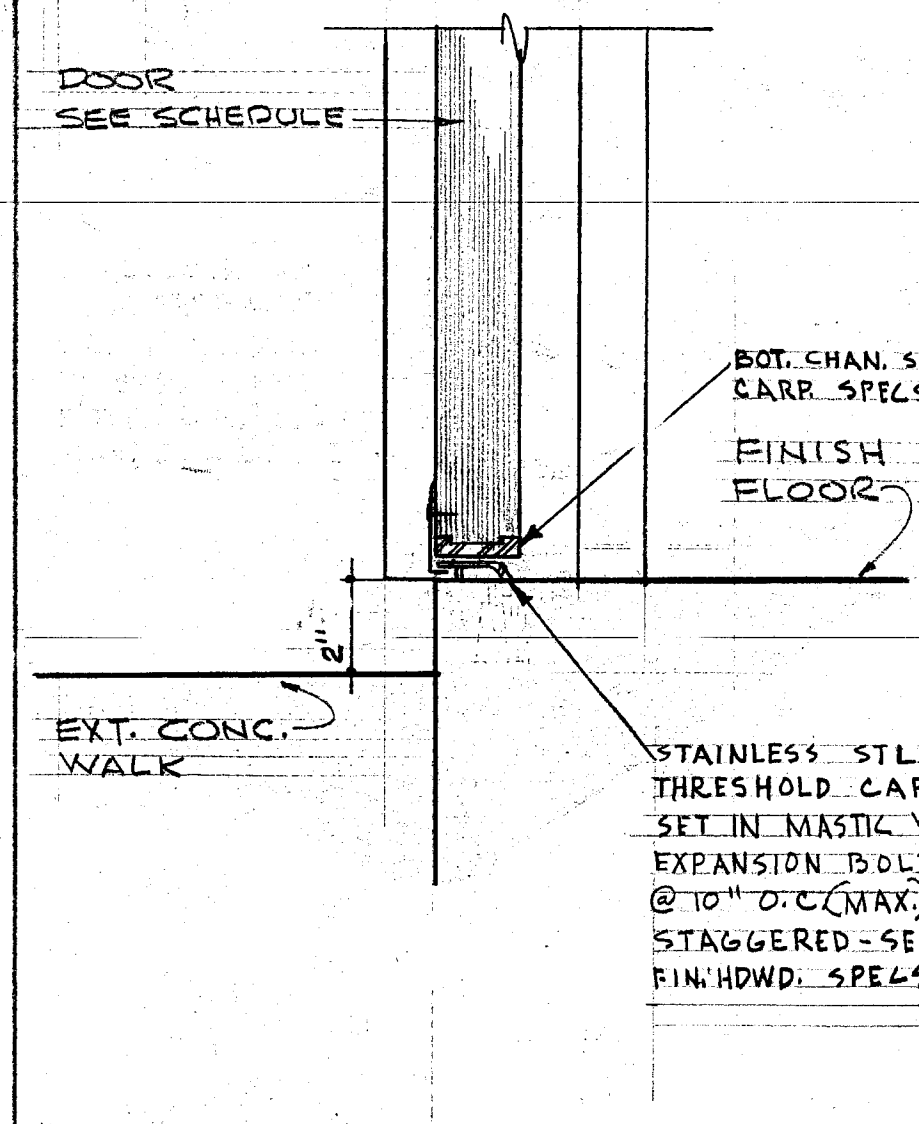


30
A10 DOOR • THRESHOLD
3" x 1'-0"

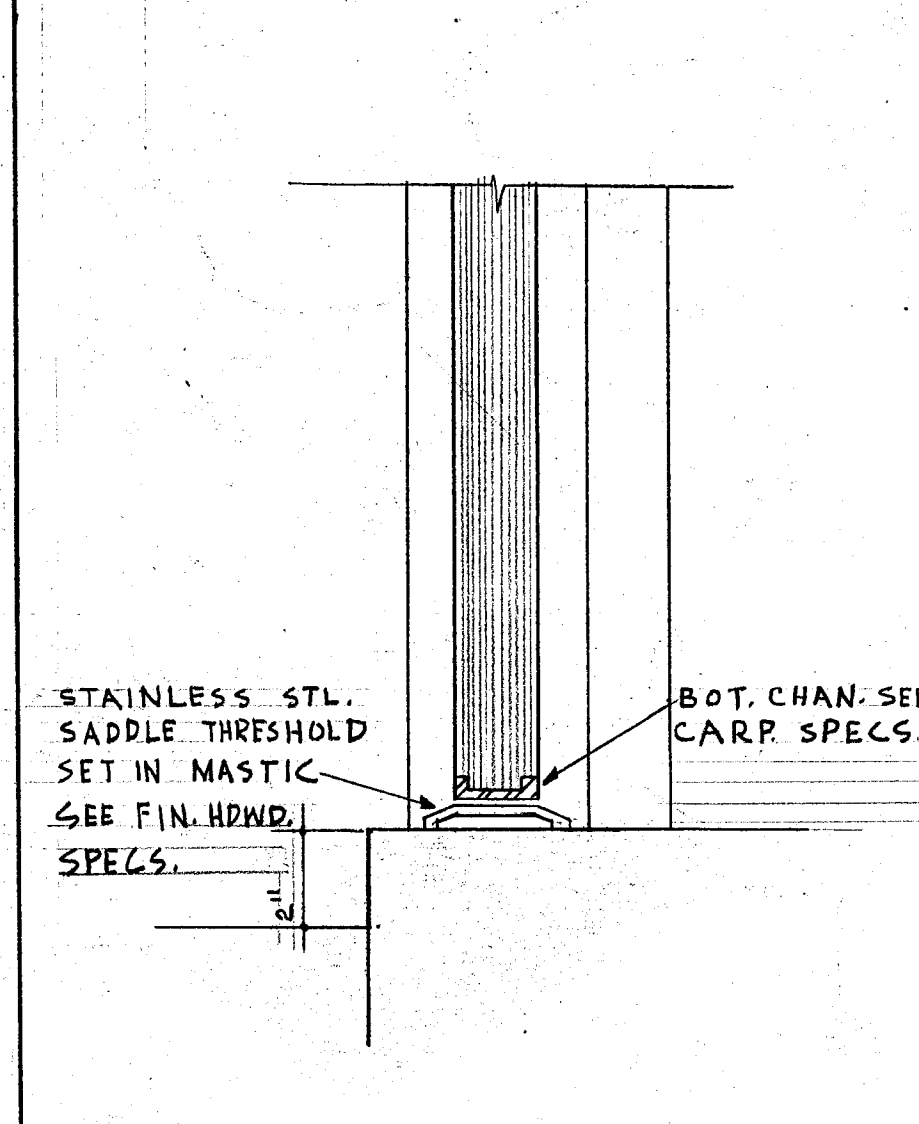


31
A10 THRESHOLD AT INSWINGING DOORS
3" x 1'-0"

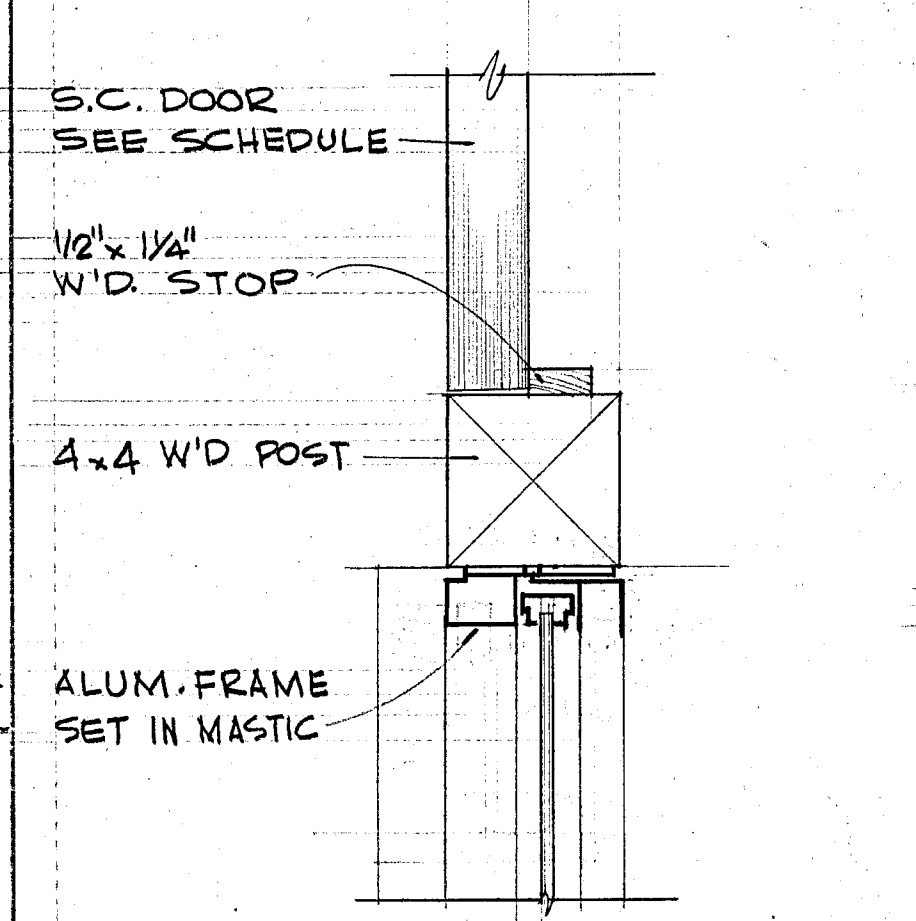


23
A10 WINDOW-DOOR MULLION

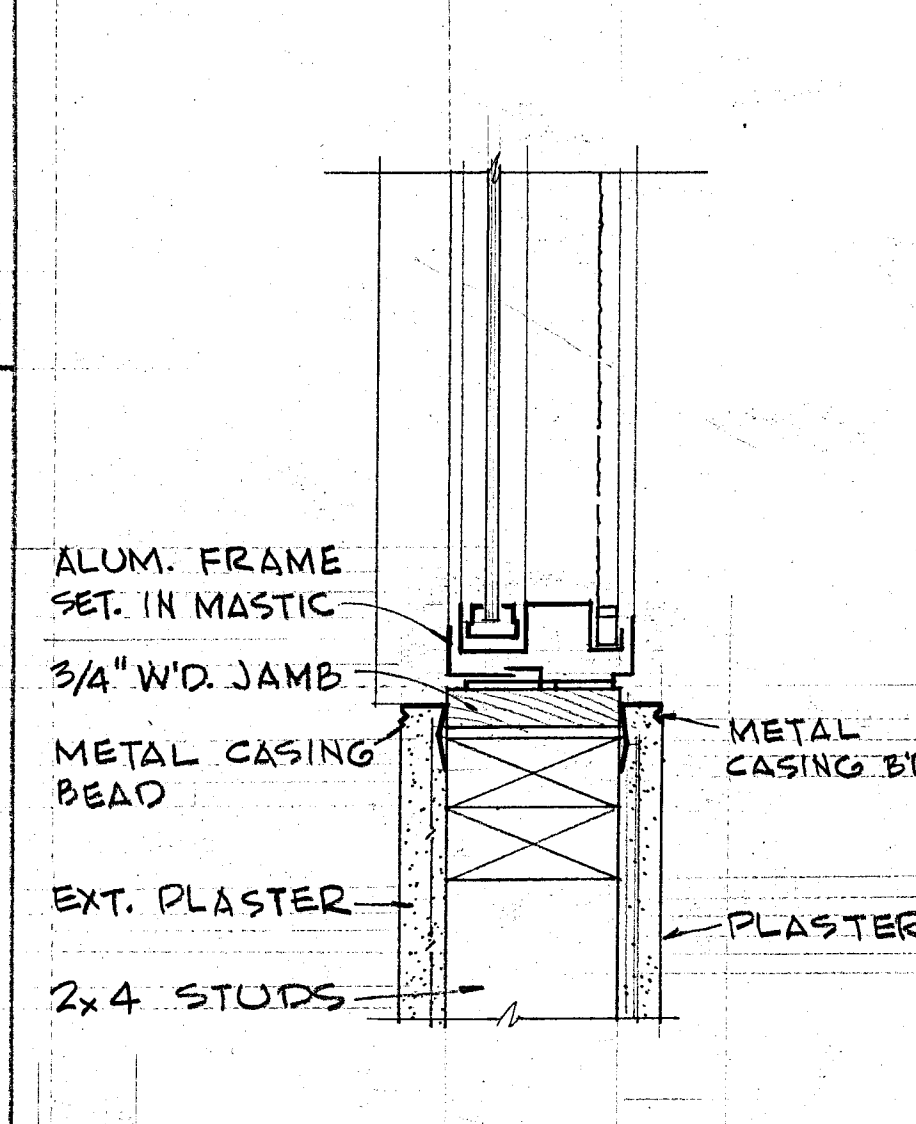


24
A10 SLIDING WINDOW • JAMB

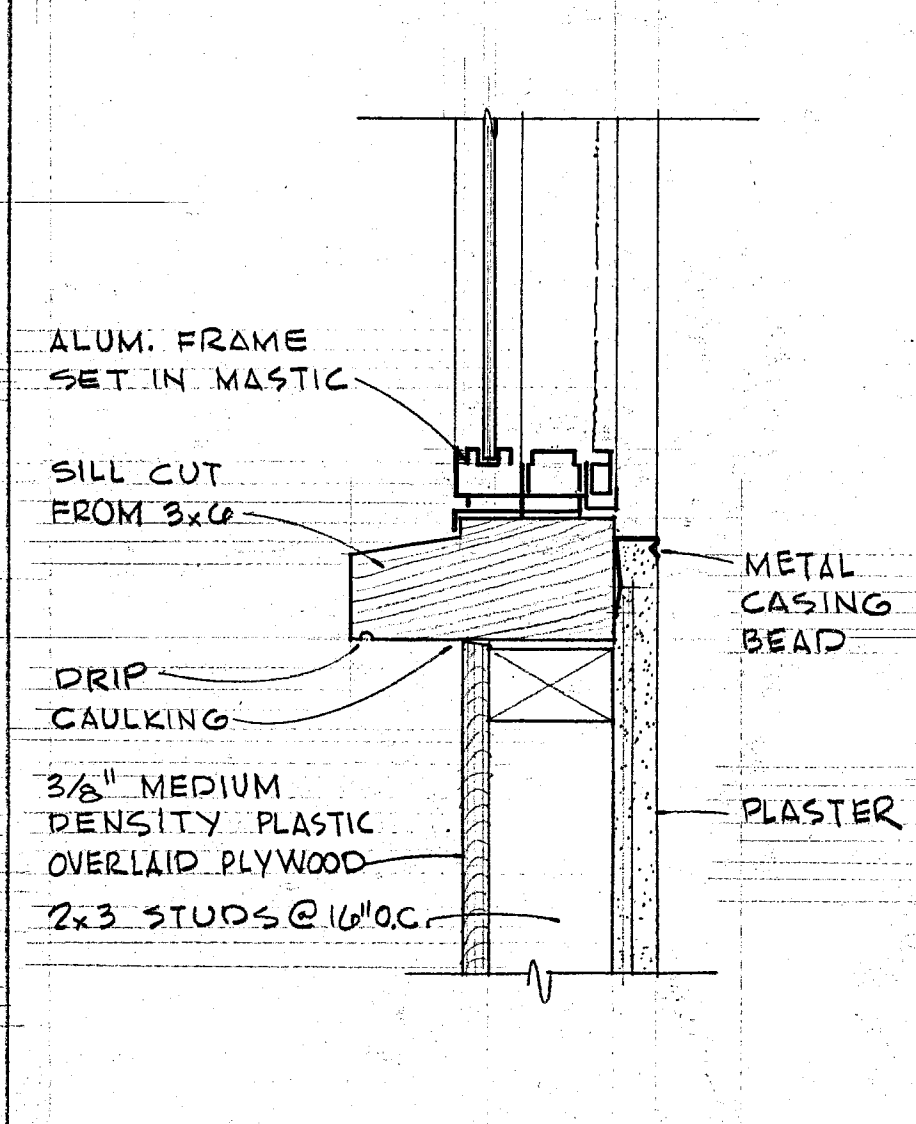


25
A10 SLIDING WINDOW • SILL

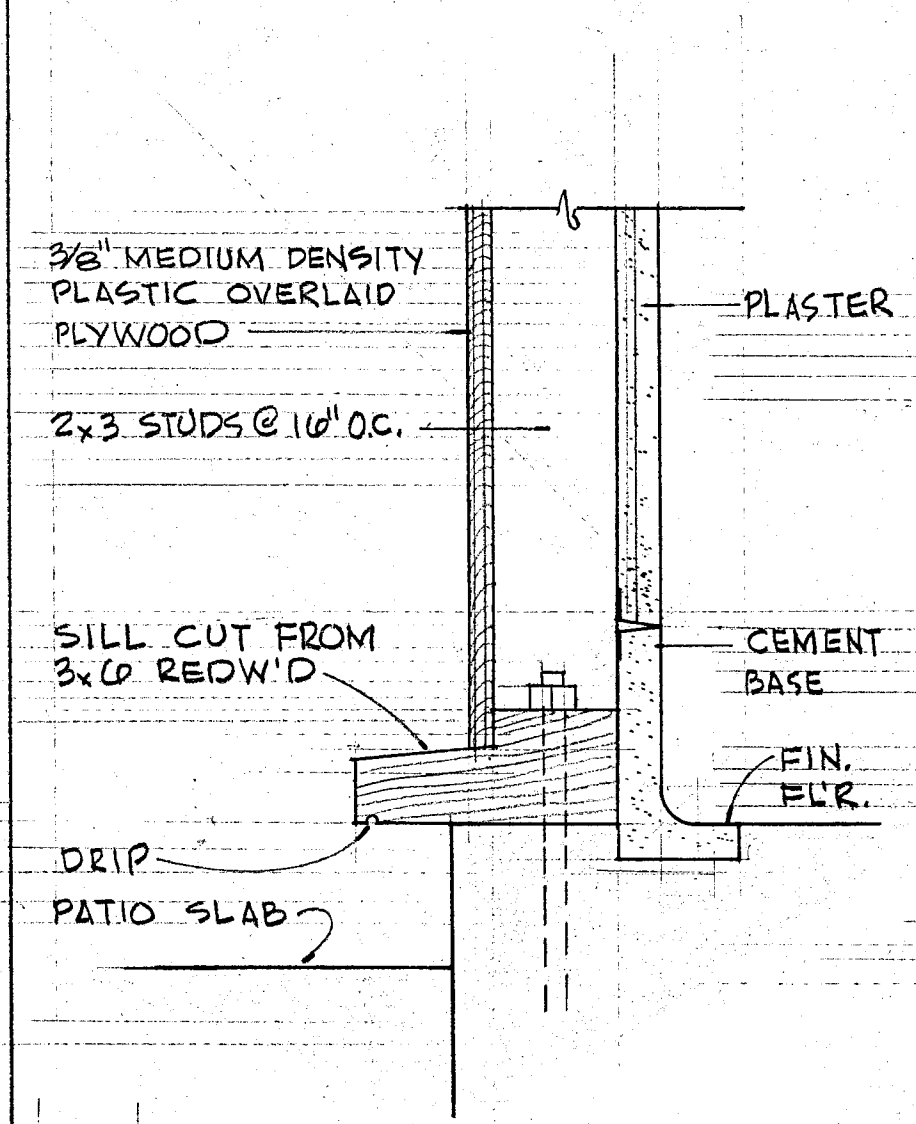


26
A10 PLYWOOD PANEL BASE

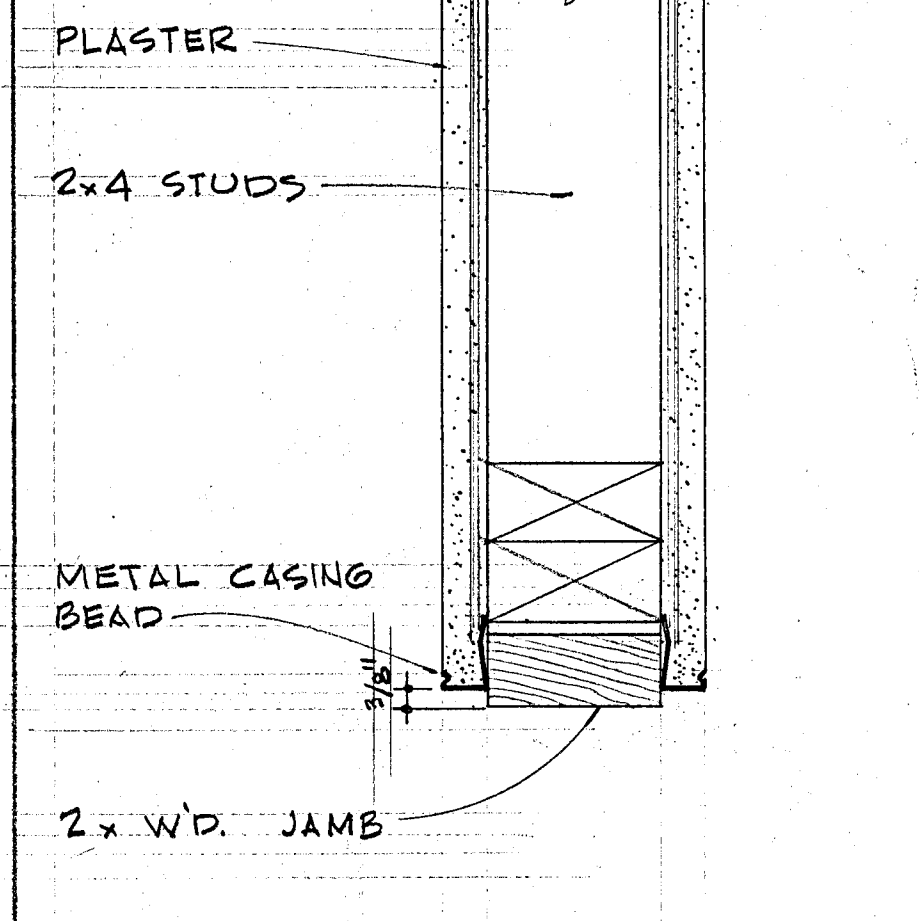


18
A10 SLIDING DOOR • JAMB

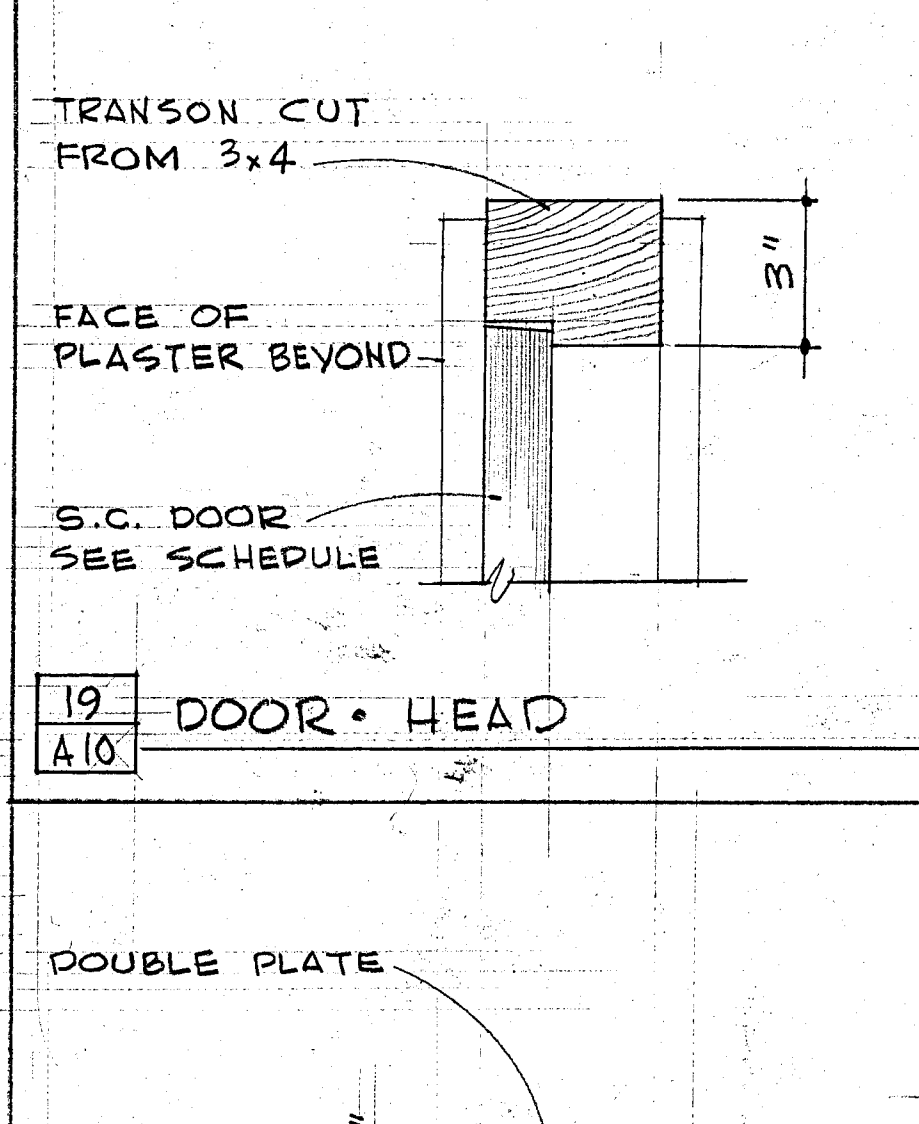


19
A10 DOOR • HEAD

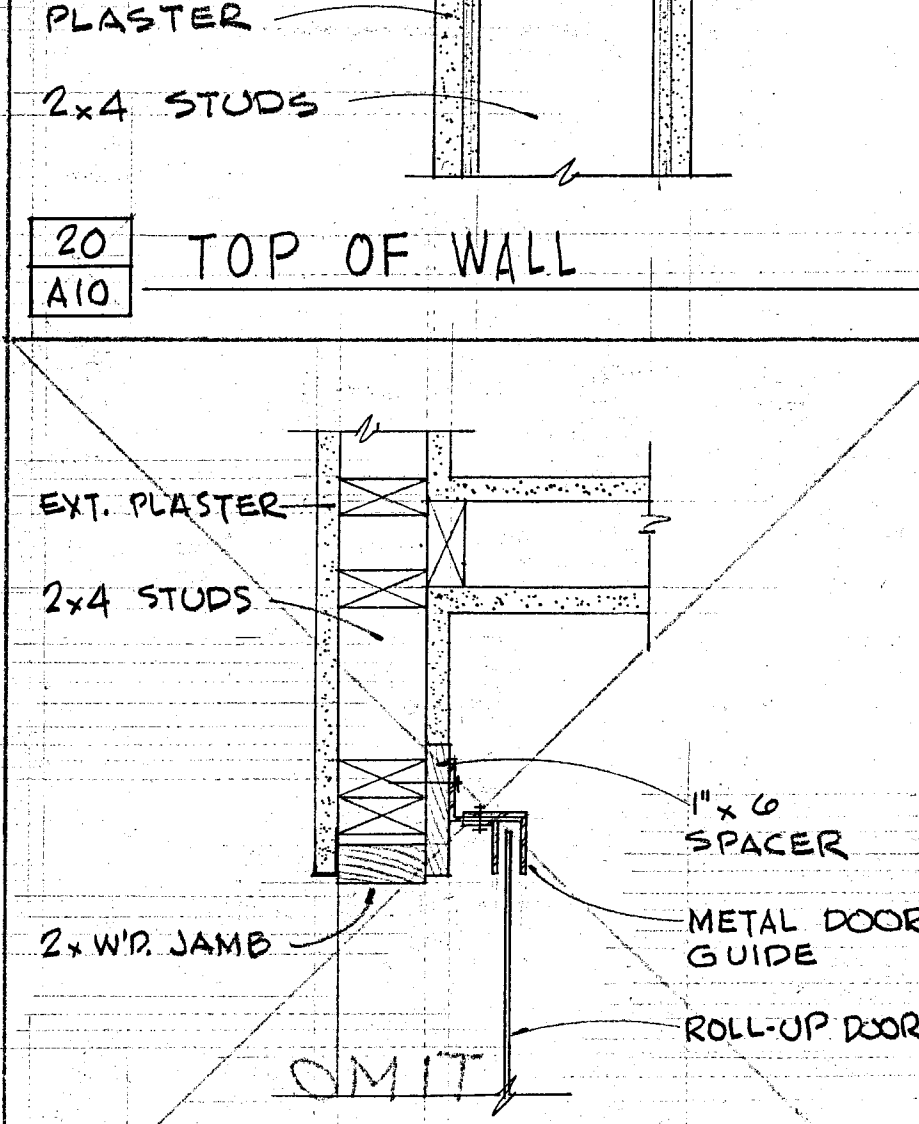


20
A10 TOP OF WALL

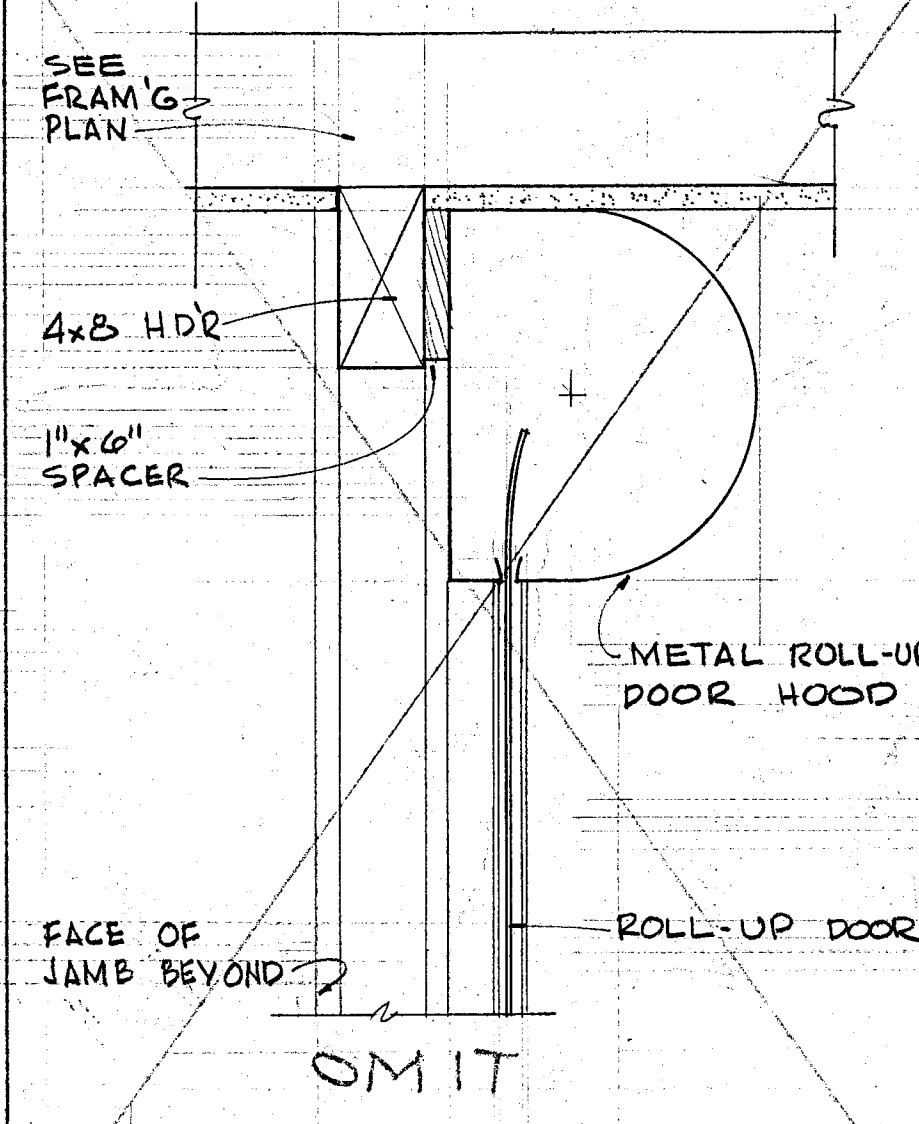


22
A10 ROLL-UP DOOR • HEAD

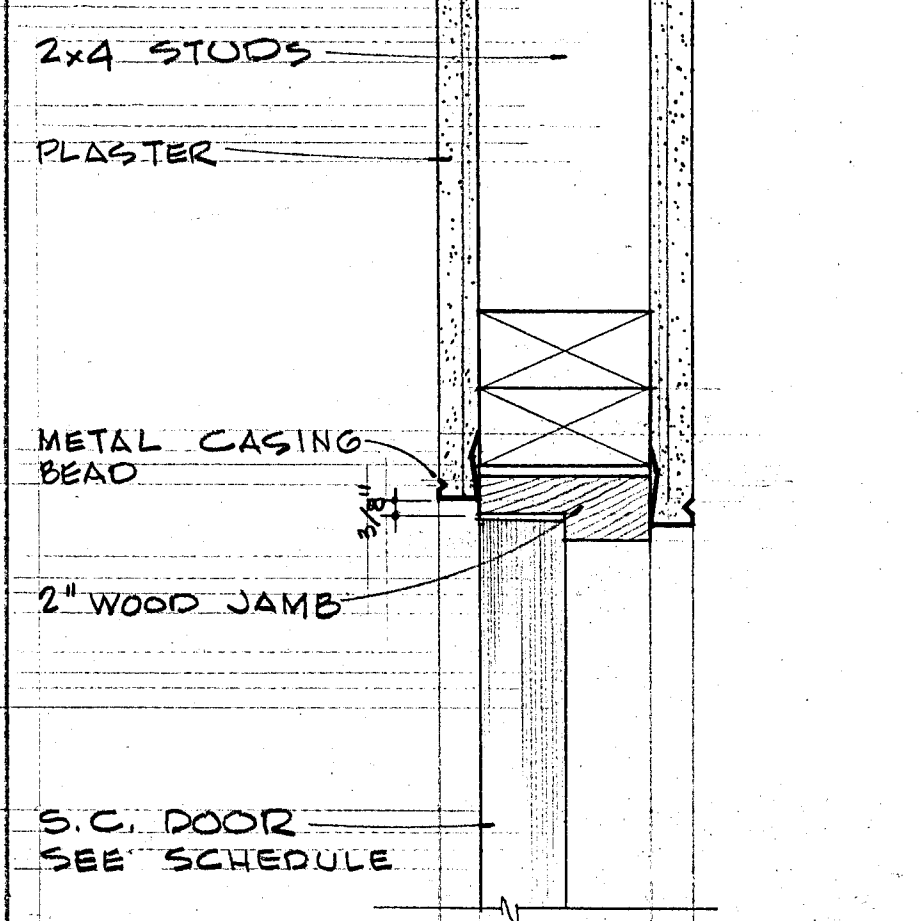


14
A10 TYP. INTERIOR DOOR JAMB

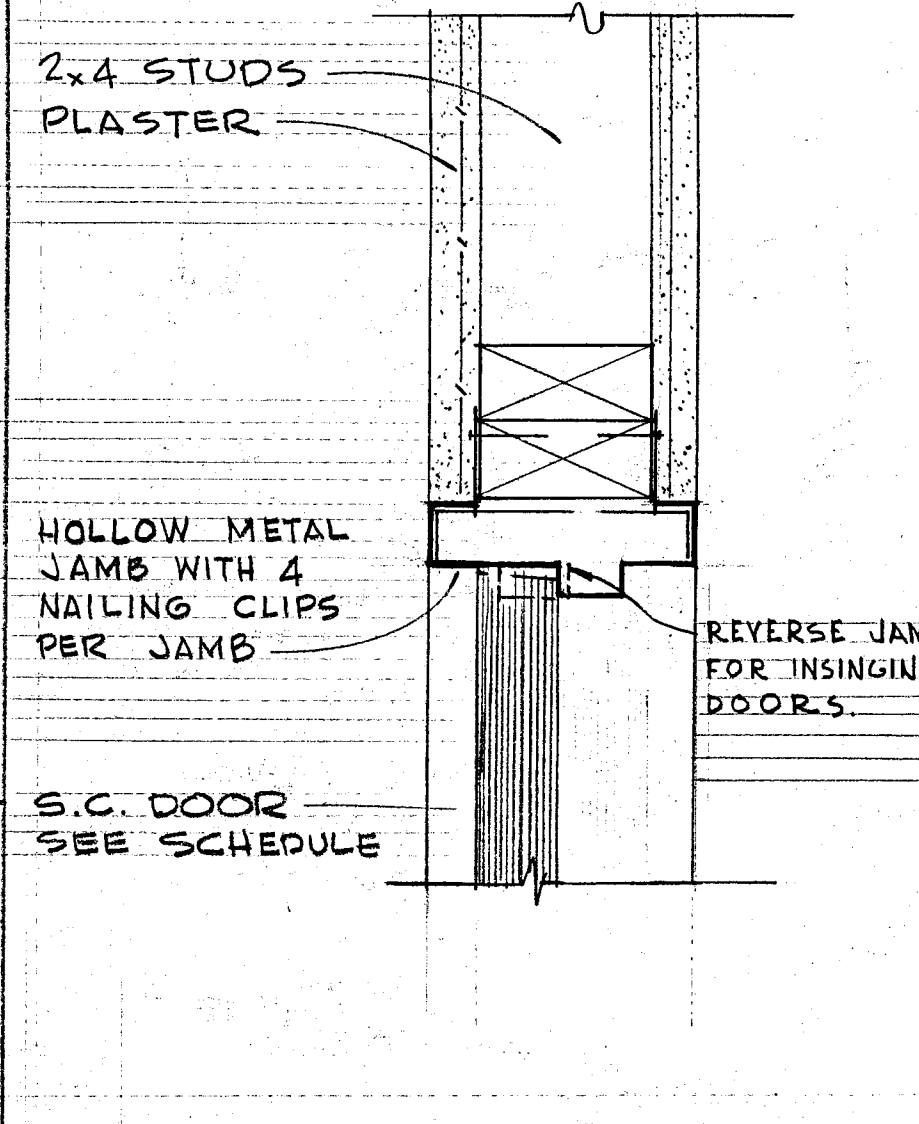


15
A10 TYP. EXTERIOR DOOR • JAMB

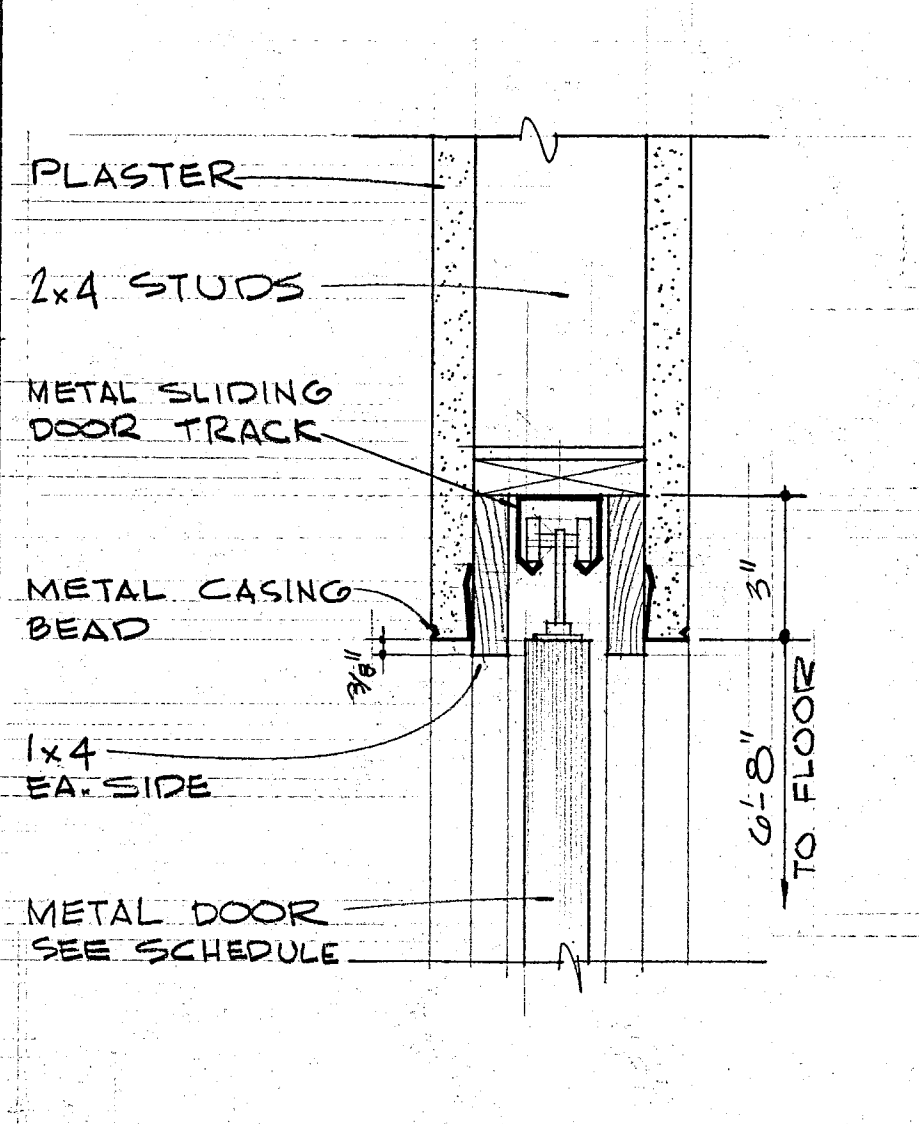


16
A10 SLIDING DOOR • HEAD

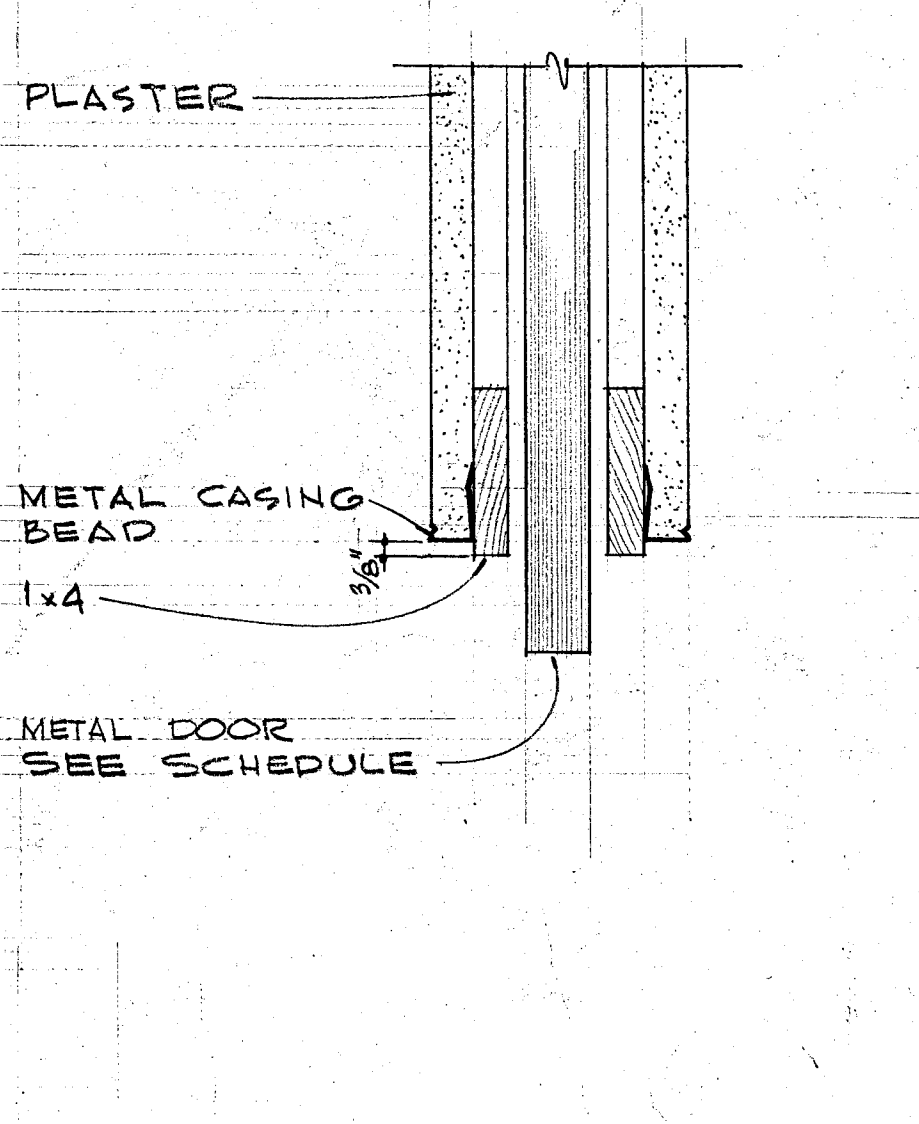


17
A10 SLIDING DOOR • JAMB

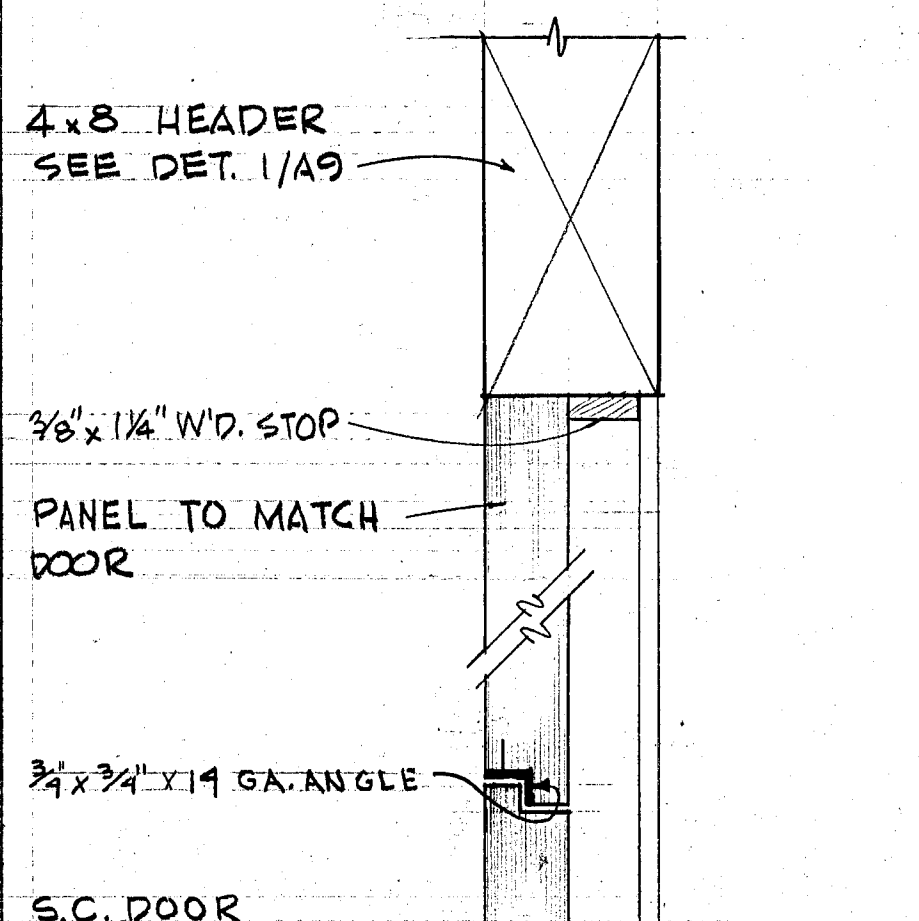


9
A10 DOOR • HEAD

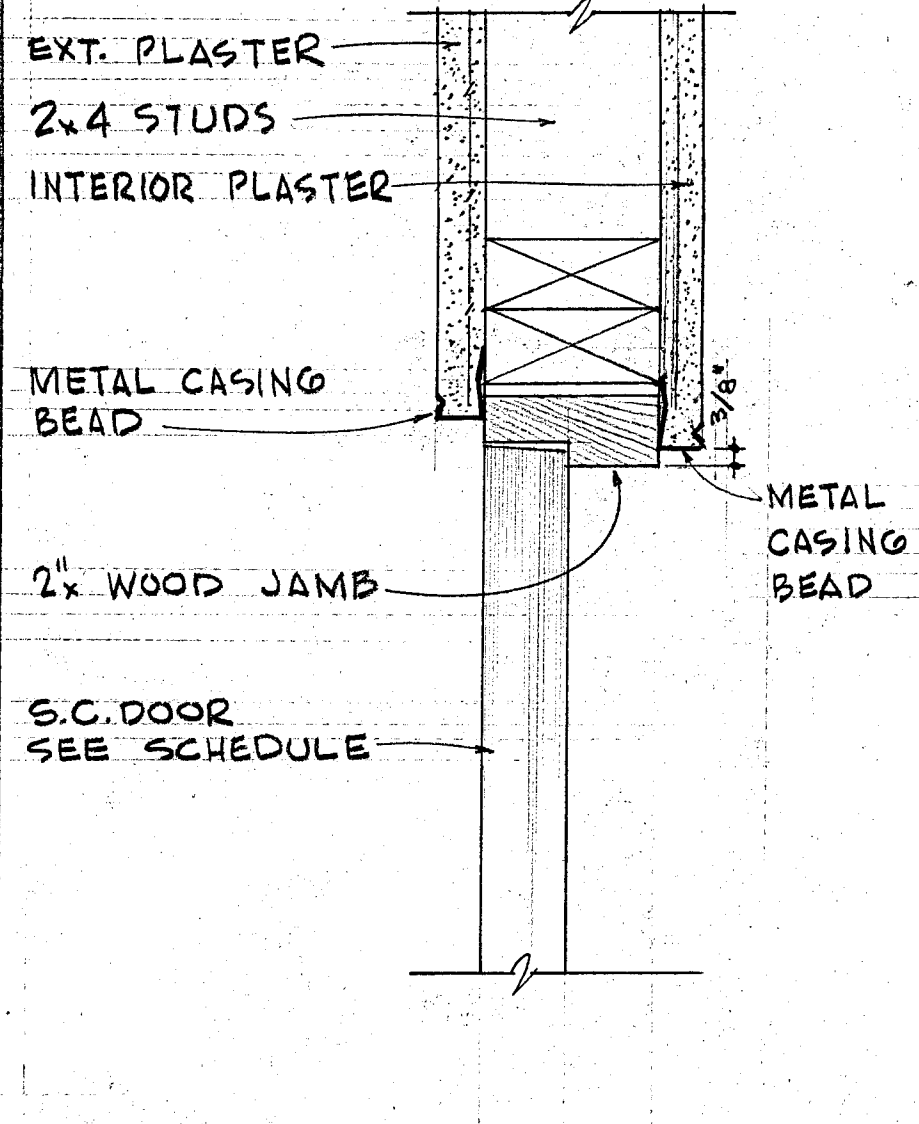


10
A10 DOOR • JAMB

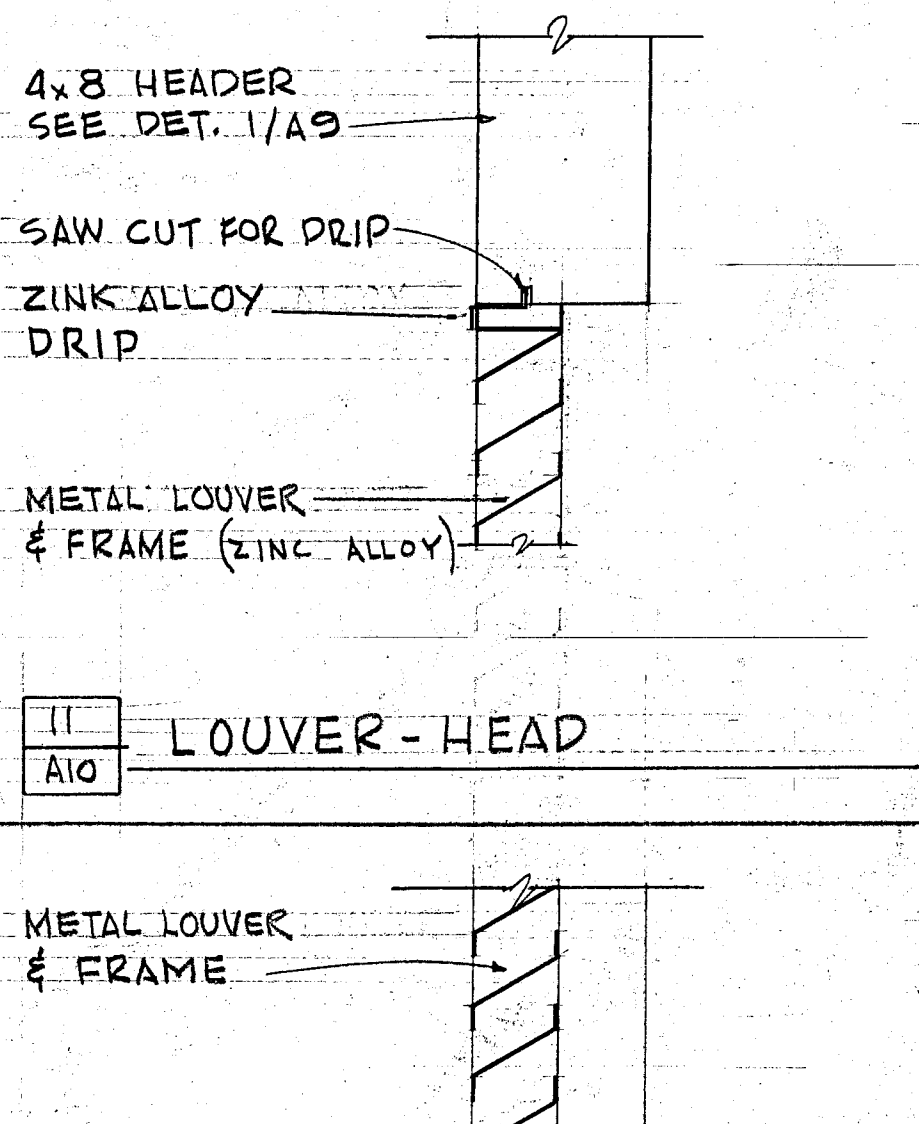


11
A10 LOUVER • HEAD

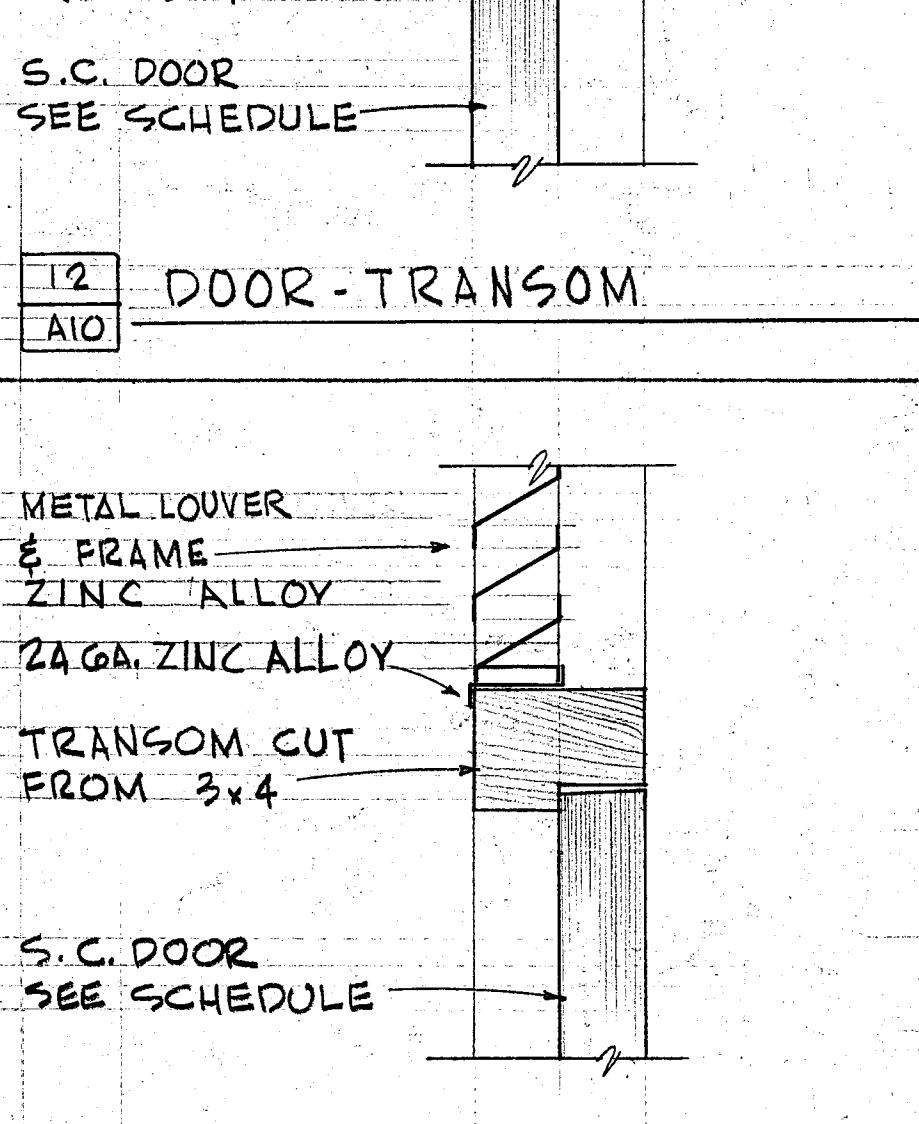


12
A10 DOOR • TRANSOM

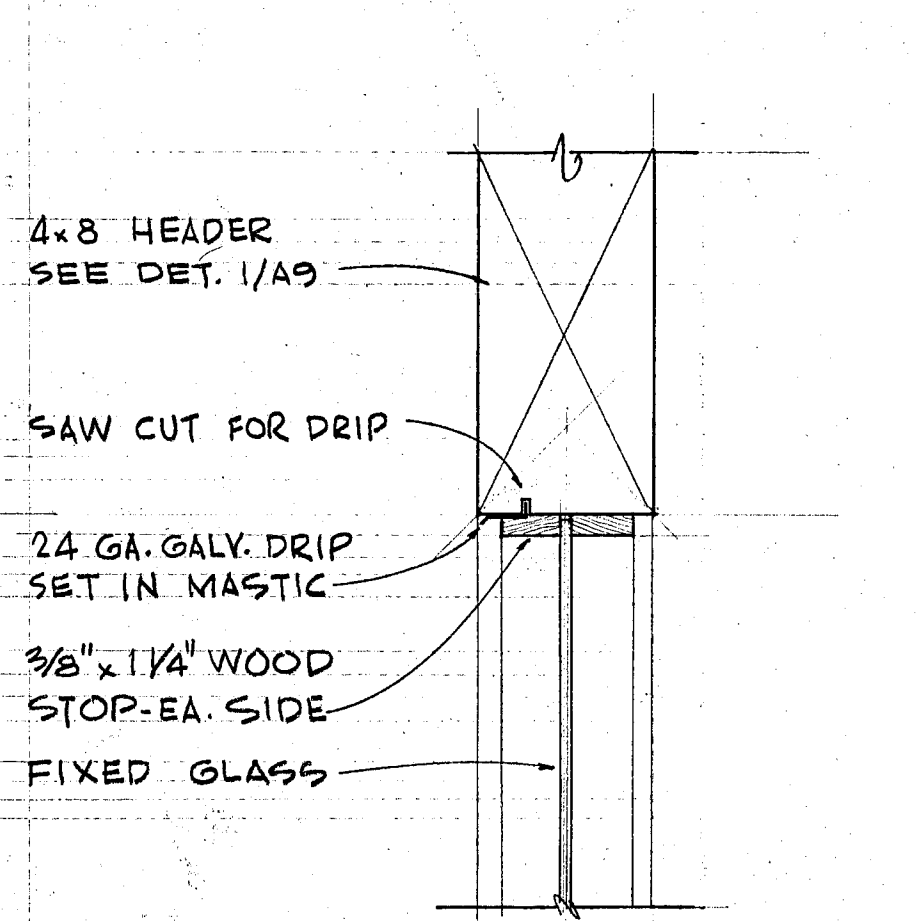


5
A10 FIXED GLASS • HEAD

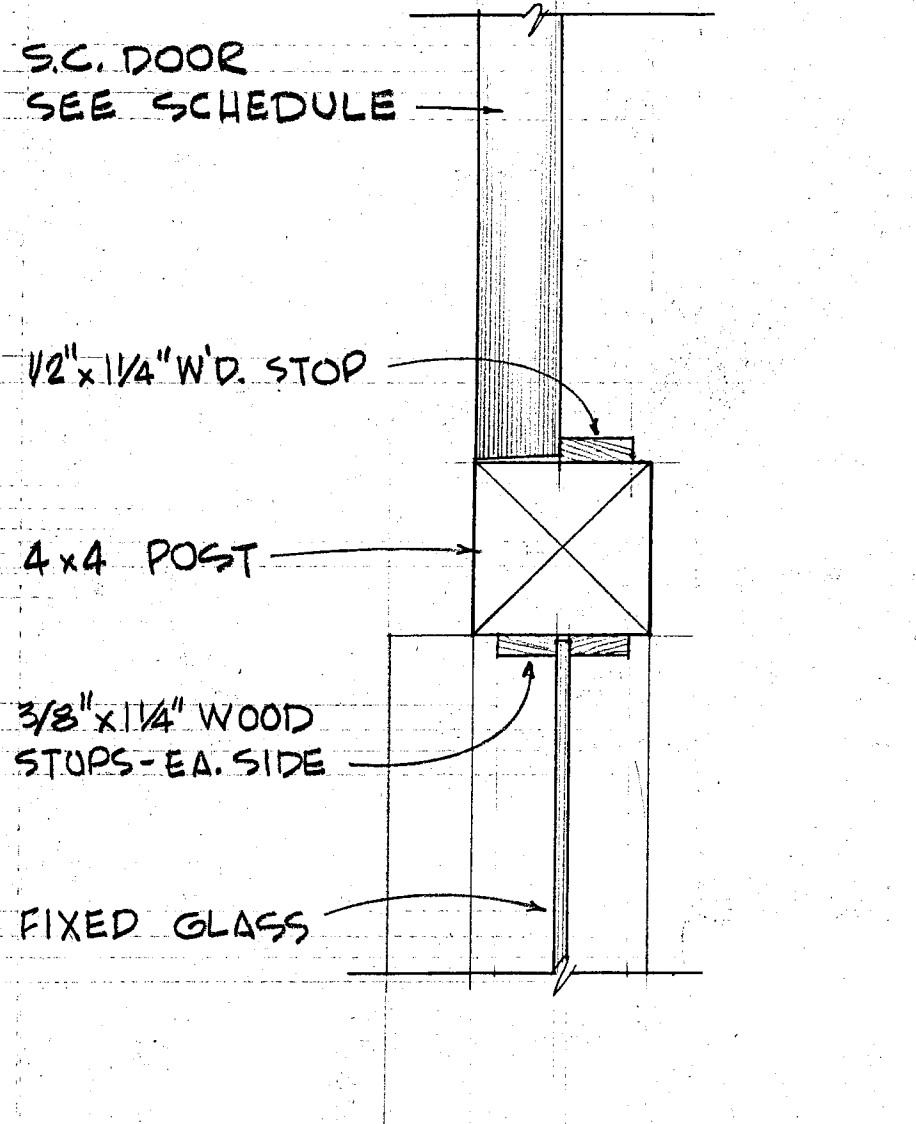


6
A10 FIXED GLASS • JAMB

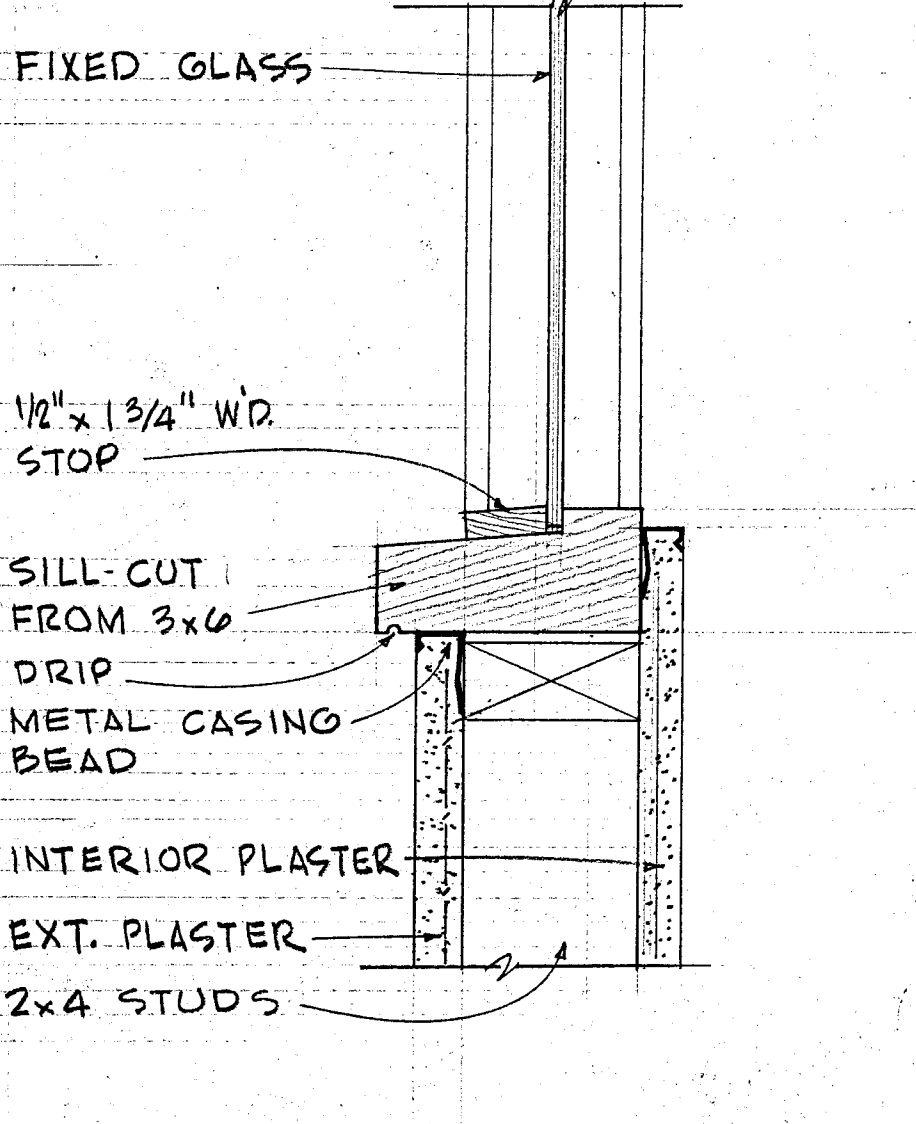


7
A10 FIXED GLASS • SILL

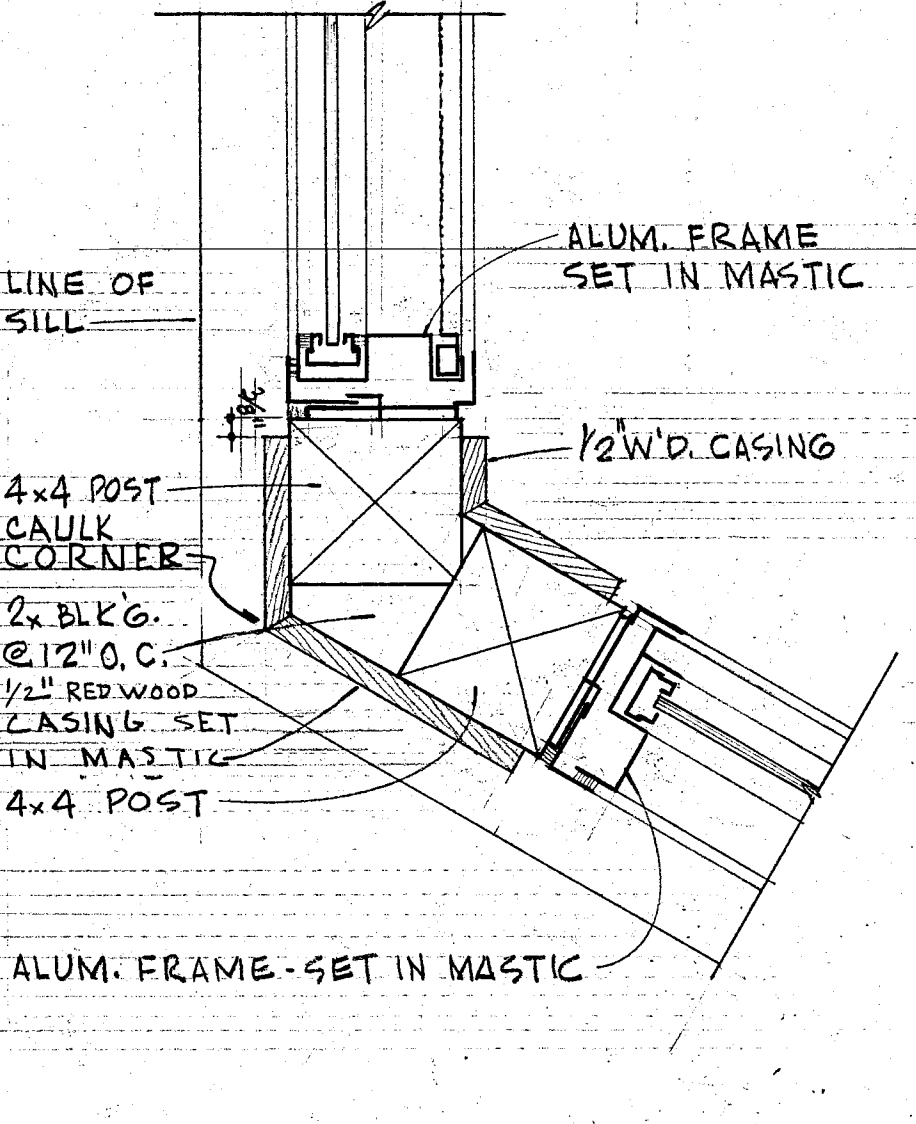


8
A10 SLIDING WINDOW • JAMB

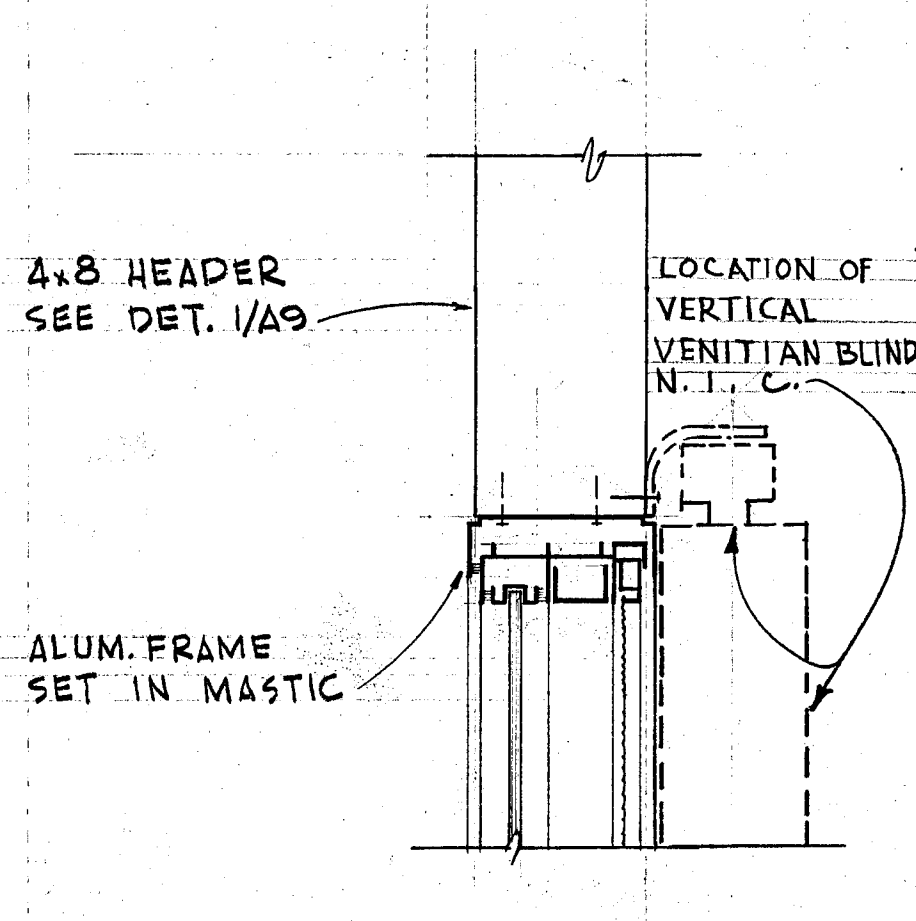


1
A10 SLIDING WINDOW • HEAD

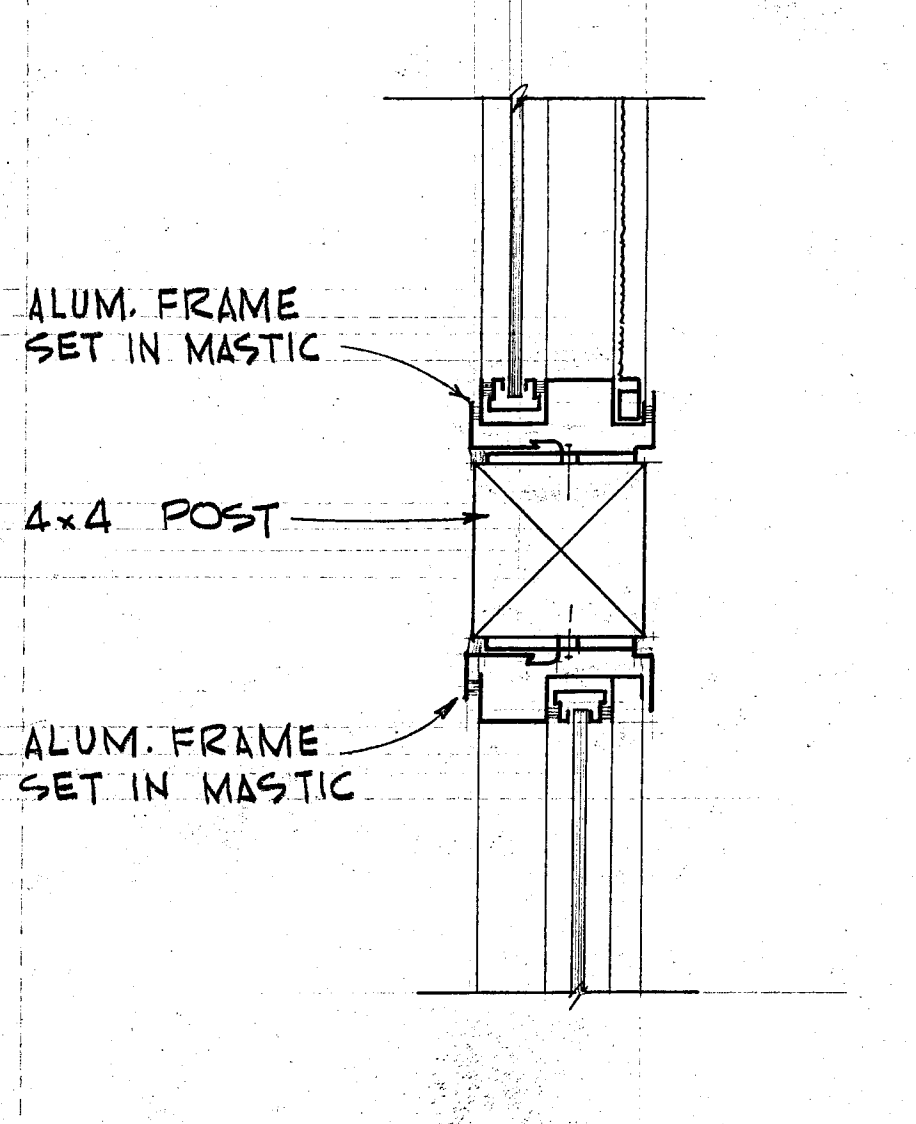

2
A10 SLIDING WINDOW • MULLION

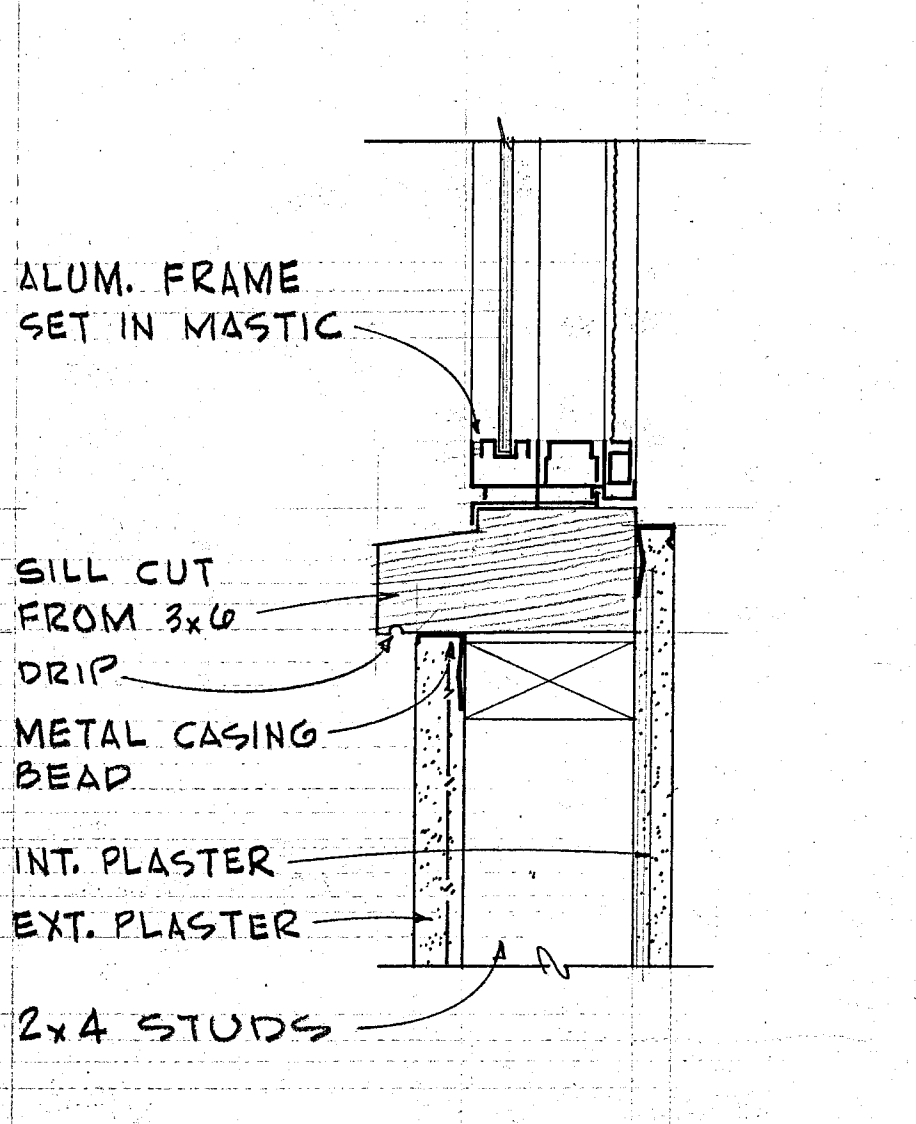

3
A10 SLIDING WINDOW • SILL

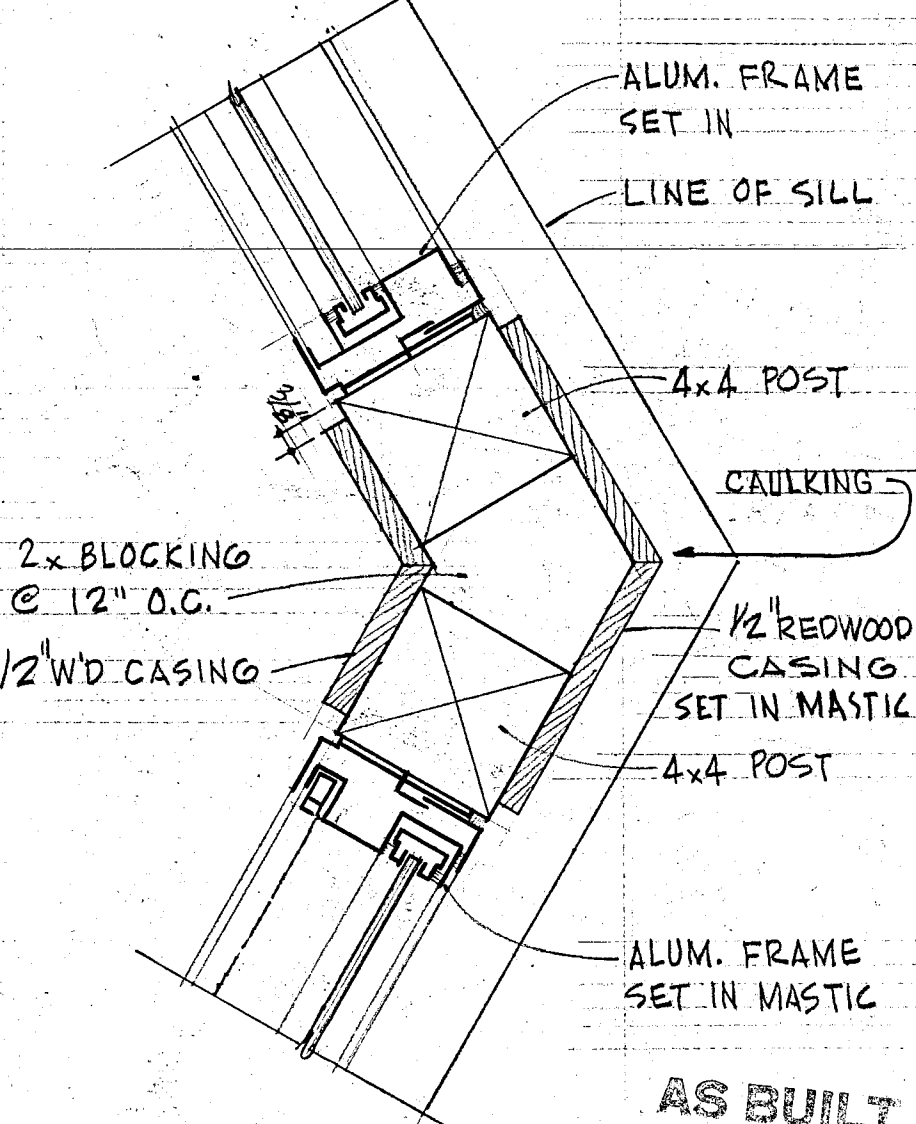

4
A10 SLIDING WINDOW • JAMB

EDWIN H. RIPPERDAN
ARCHITECT
3610 LONG BEACH BLVD • LONG BEACH • CALIF. 424-6701

REVISIONS
ACTIVITY BUILDING & GENERAL DEVELOPMENT FOR THE COUNTY OF LOS ANGELES
PALOS VERDES COUNTY PARK
30359 S. HAWTHORNE BLVD. PALOS VERDES • CALIFORNIA

AS-BUILT CORRECTIONS
SCALE: 3" = 1'-0"
DRAWN BY: HC & RS.
CHECKED BY: E.H.R.
DATE: 6-8-64
REVISED: 1-25-66
ARCH. JOB NO: 628

DETAILS
SHEET
SPEC. NO. 2379
A10
OF 14