


**LEGEND**

- - VALVE # BOX
- - HEAD
- X - TYPE G HEAD
- ⊗ - GATE VALVE
- ⊠ - VALVE SEQUENCE
- ⊞ - TYPE OF HEAD
- - - - - MAINLINE

RANCHO PALOS VERDES PARK  
 AS-BUILT IRRIGATION PLAN  
 1201  
 HANGER 47430

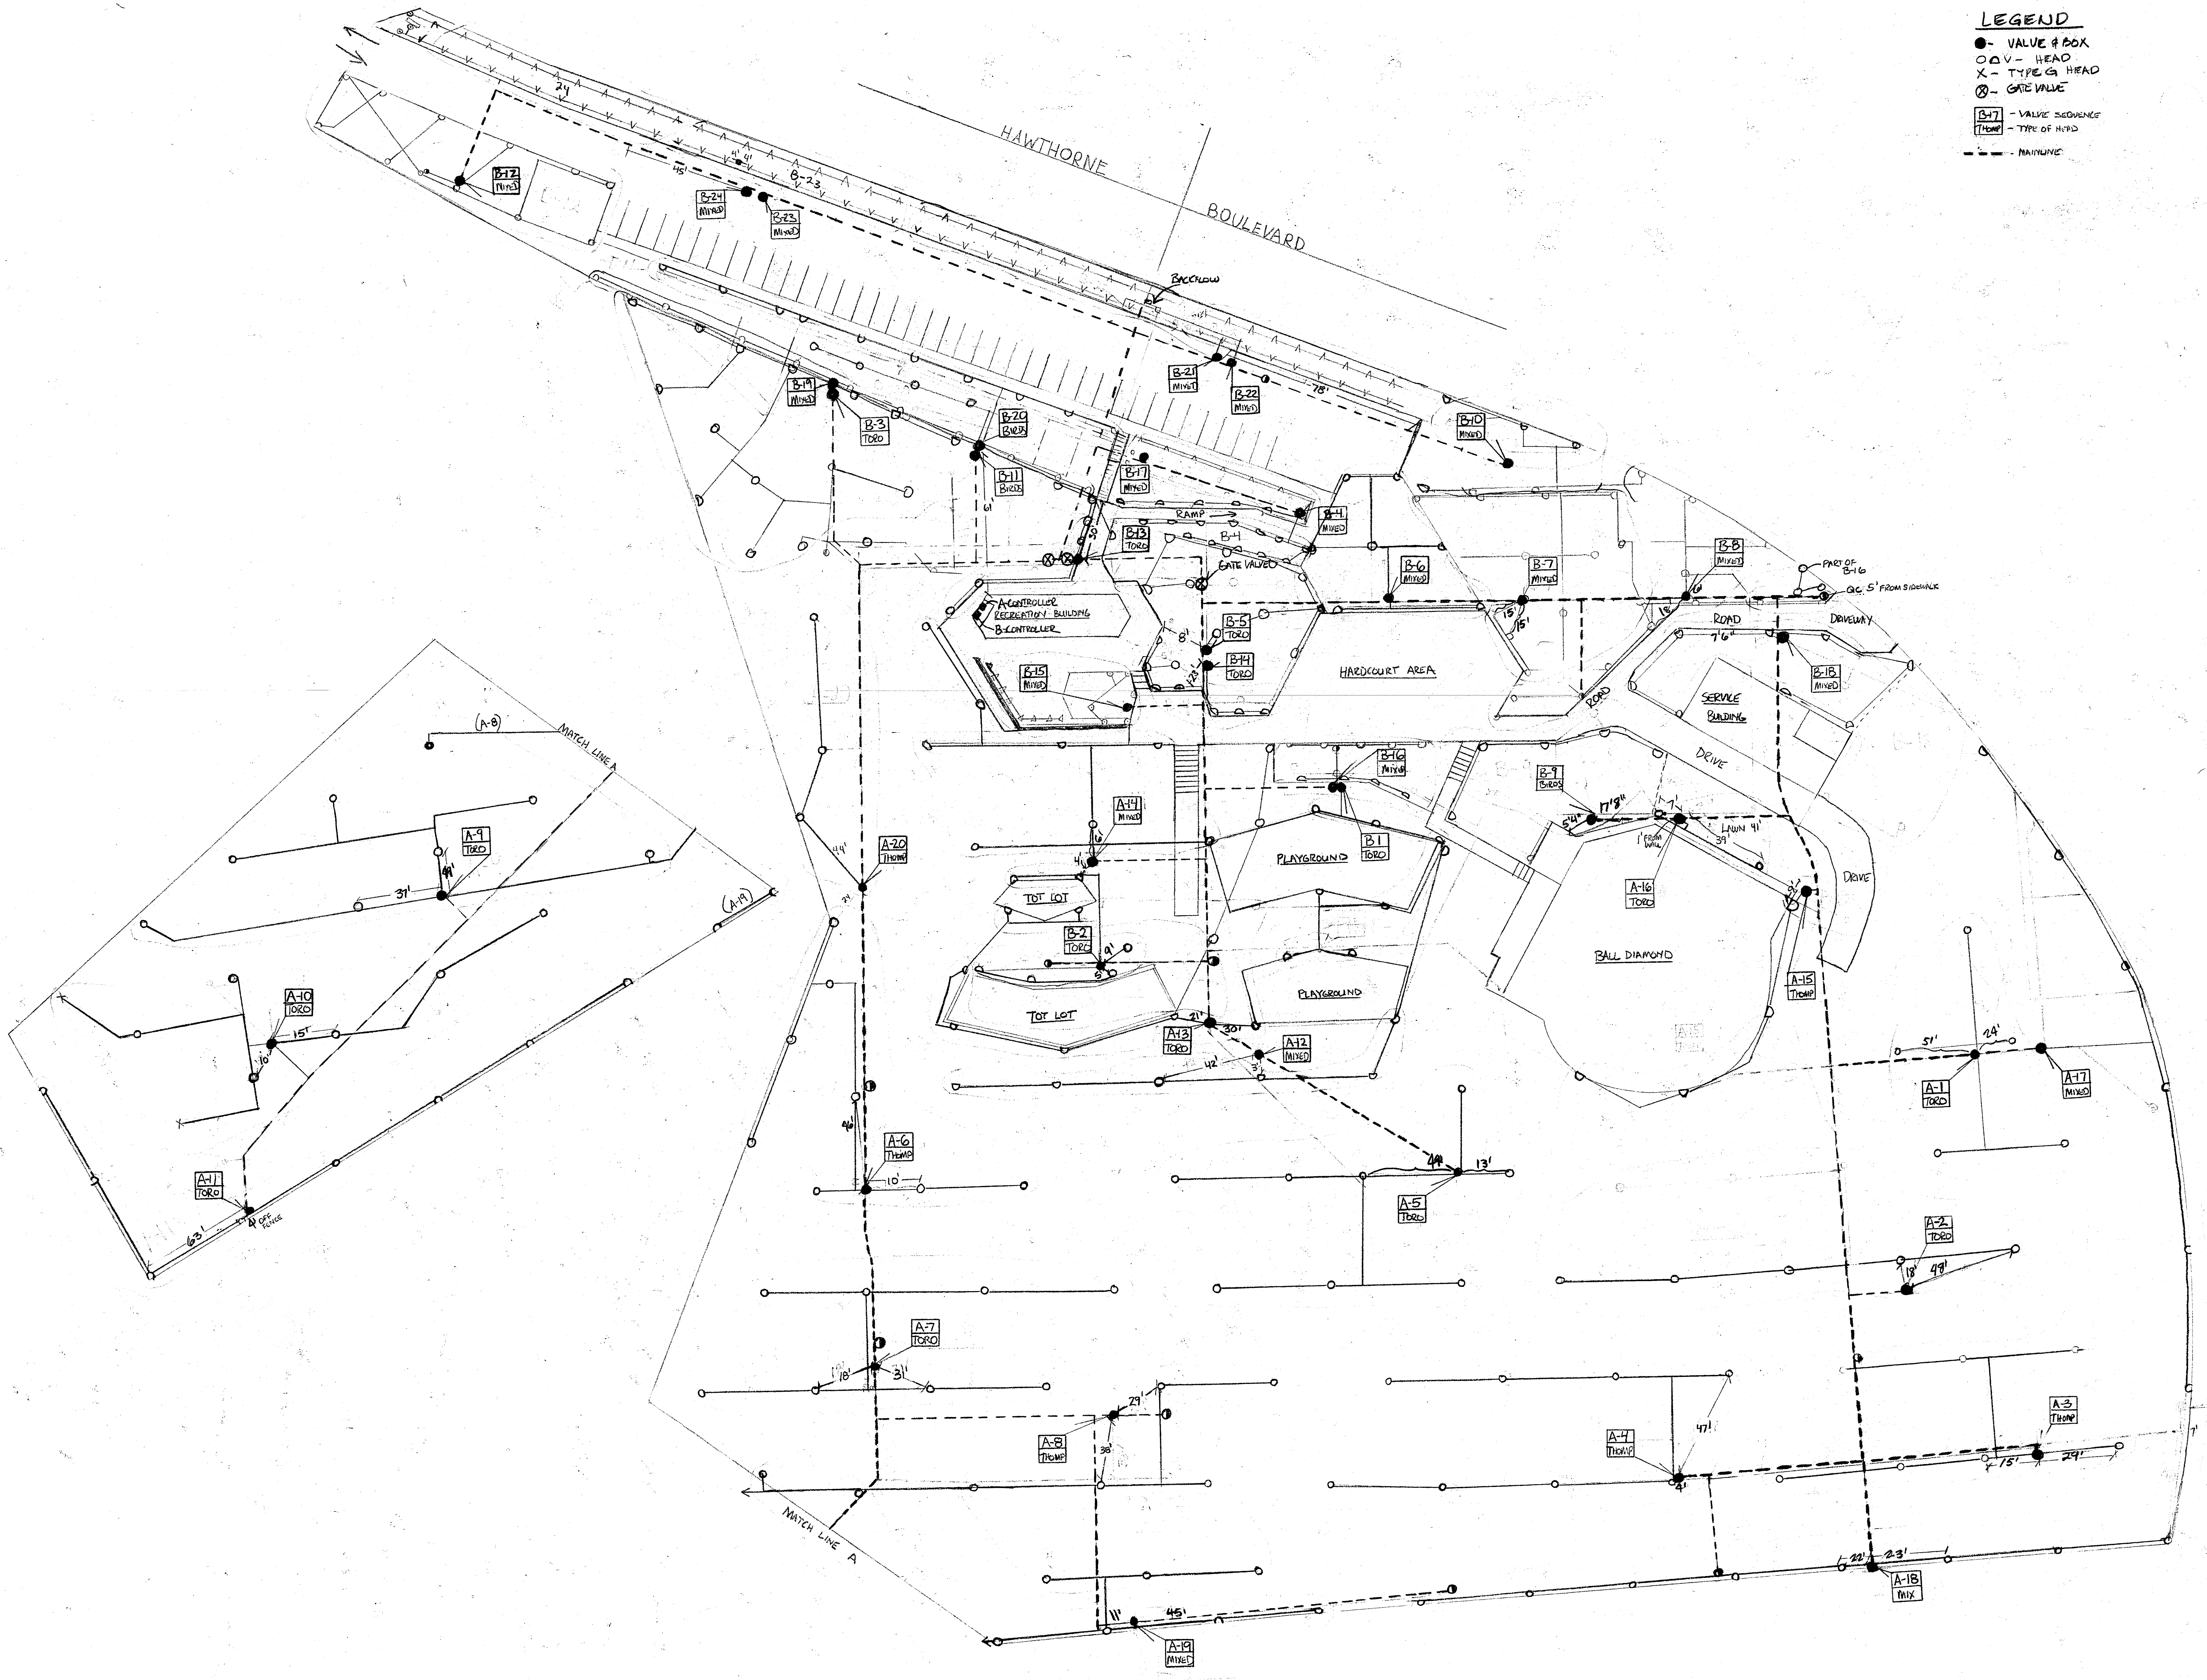

**RANCHO PALOS VERDES PARK**

**AS-BUILT IRRIGATION PLAN**

|                  |                 |                        |           |                  |
|------------------|-----------------|------------------------|-----------|------------------|
| AS-BUILT DRAWING | SCALE: 1" = 30' | DRAWN BY: G. BLACKWELL | CHECK BY: | DATE: MARCH 1964 |
|------------------|-----------------|------------------------|-----------|------------------|