


- LEGEND**
- - VALVE & BOX
 - - VALVE HEAD
 - X - TYPE G HEAD
 - ⊗ - GATE VALVE
 - ⊠ - VALVE SEQUENCE
 - ⊡ - TYPE OF HEAD
 - - MAINLINE

R.P.V. Park 1201
 Irrigation Plan- As built
 DATE FILE CORP. IRVINE, CA
 HANDED OFF

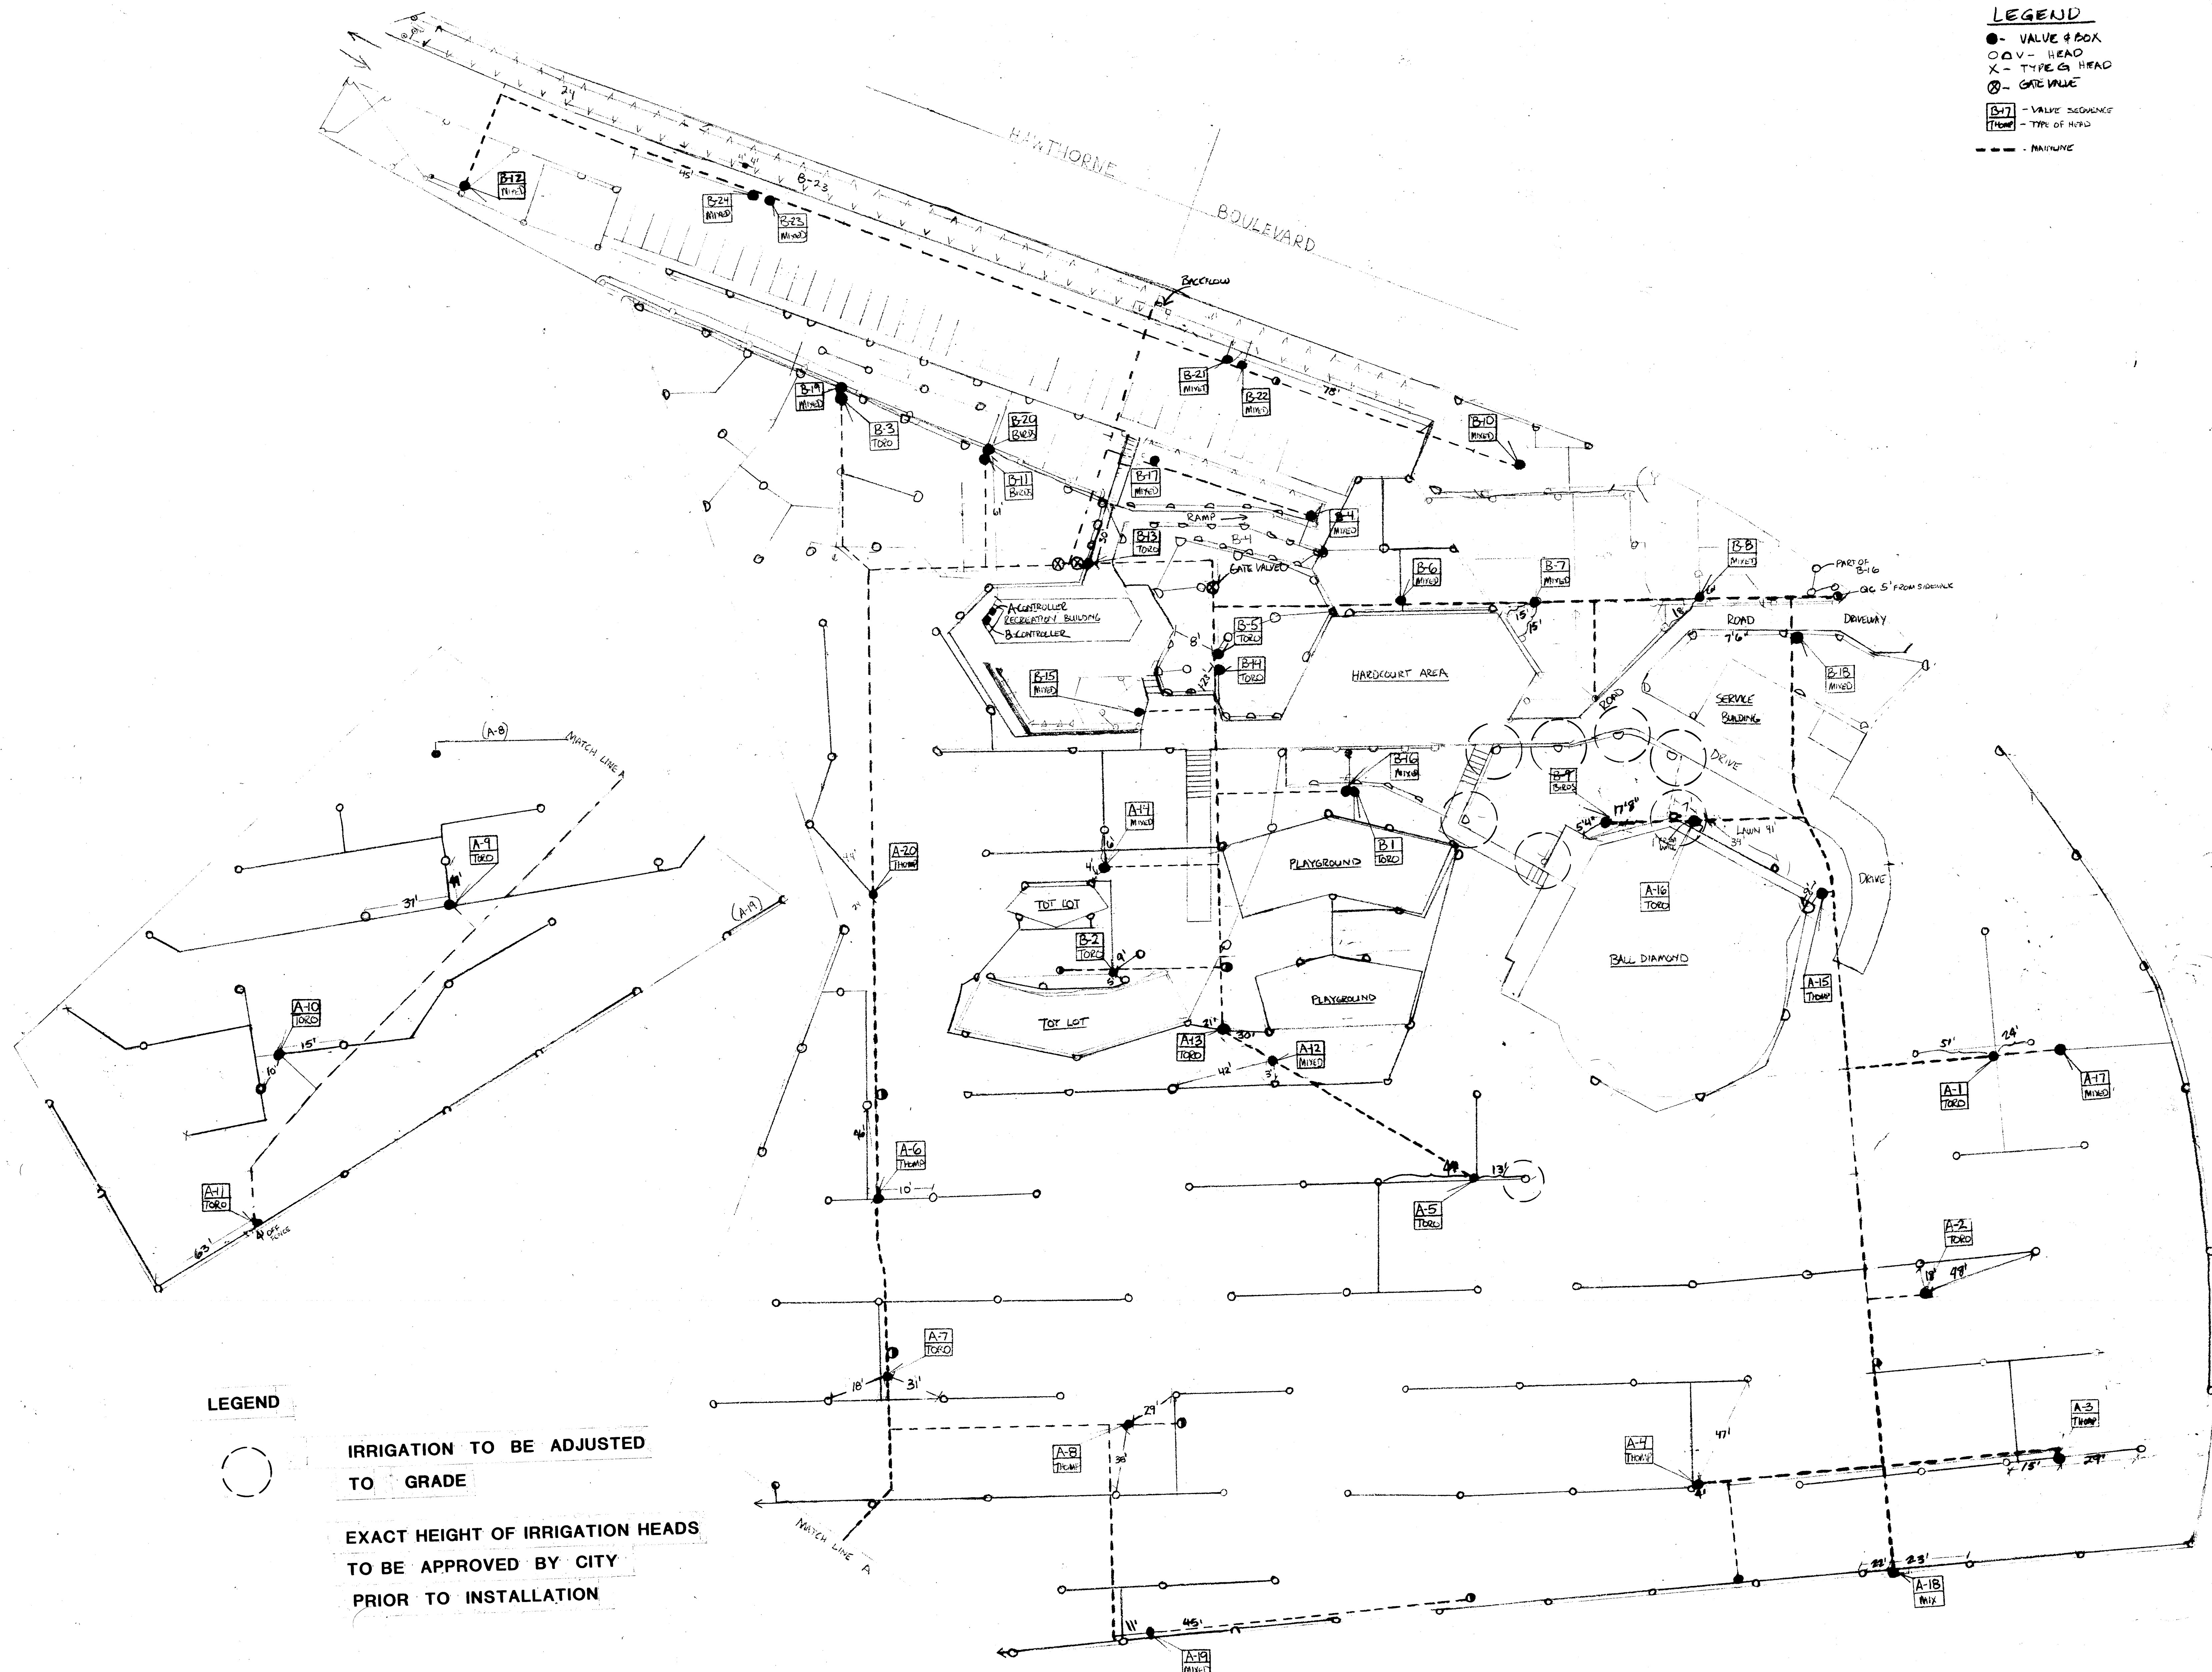

LEGEND

○ IRRIGATION TO BE ADJUSTED TO GRADE

○ EXACT HEIGHT OF IRRIGATION HEADS TO BE APPROVED BY CITY PRIOR TO INSTALLATION

DETAIL 1

RANCHO PALOS VERDES PARK

AS-BUILT IRRIGATION PLAN		DATE: 11/24/84
AS-BUILT DRAWING SCALE: 1"=30'	DRAWN BY: G. BLACKWELL	CHECK BY: 97