


20' Duplex Power Outlet
 Box out 12" high
 Projector
 Dk stained conc floor in Exhibit Exn
 Grains & Shanks

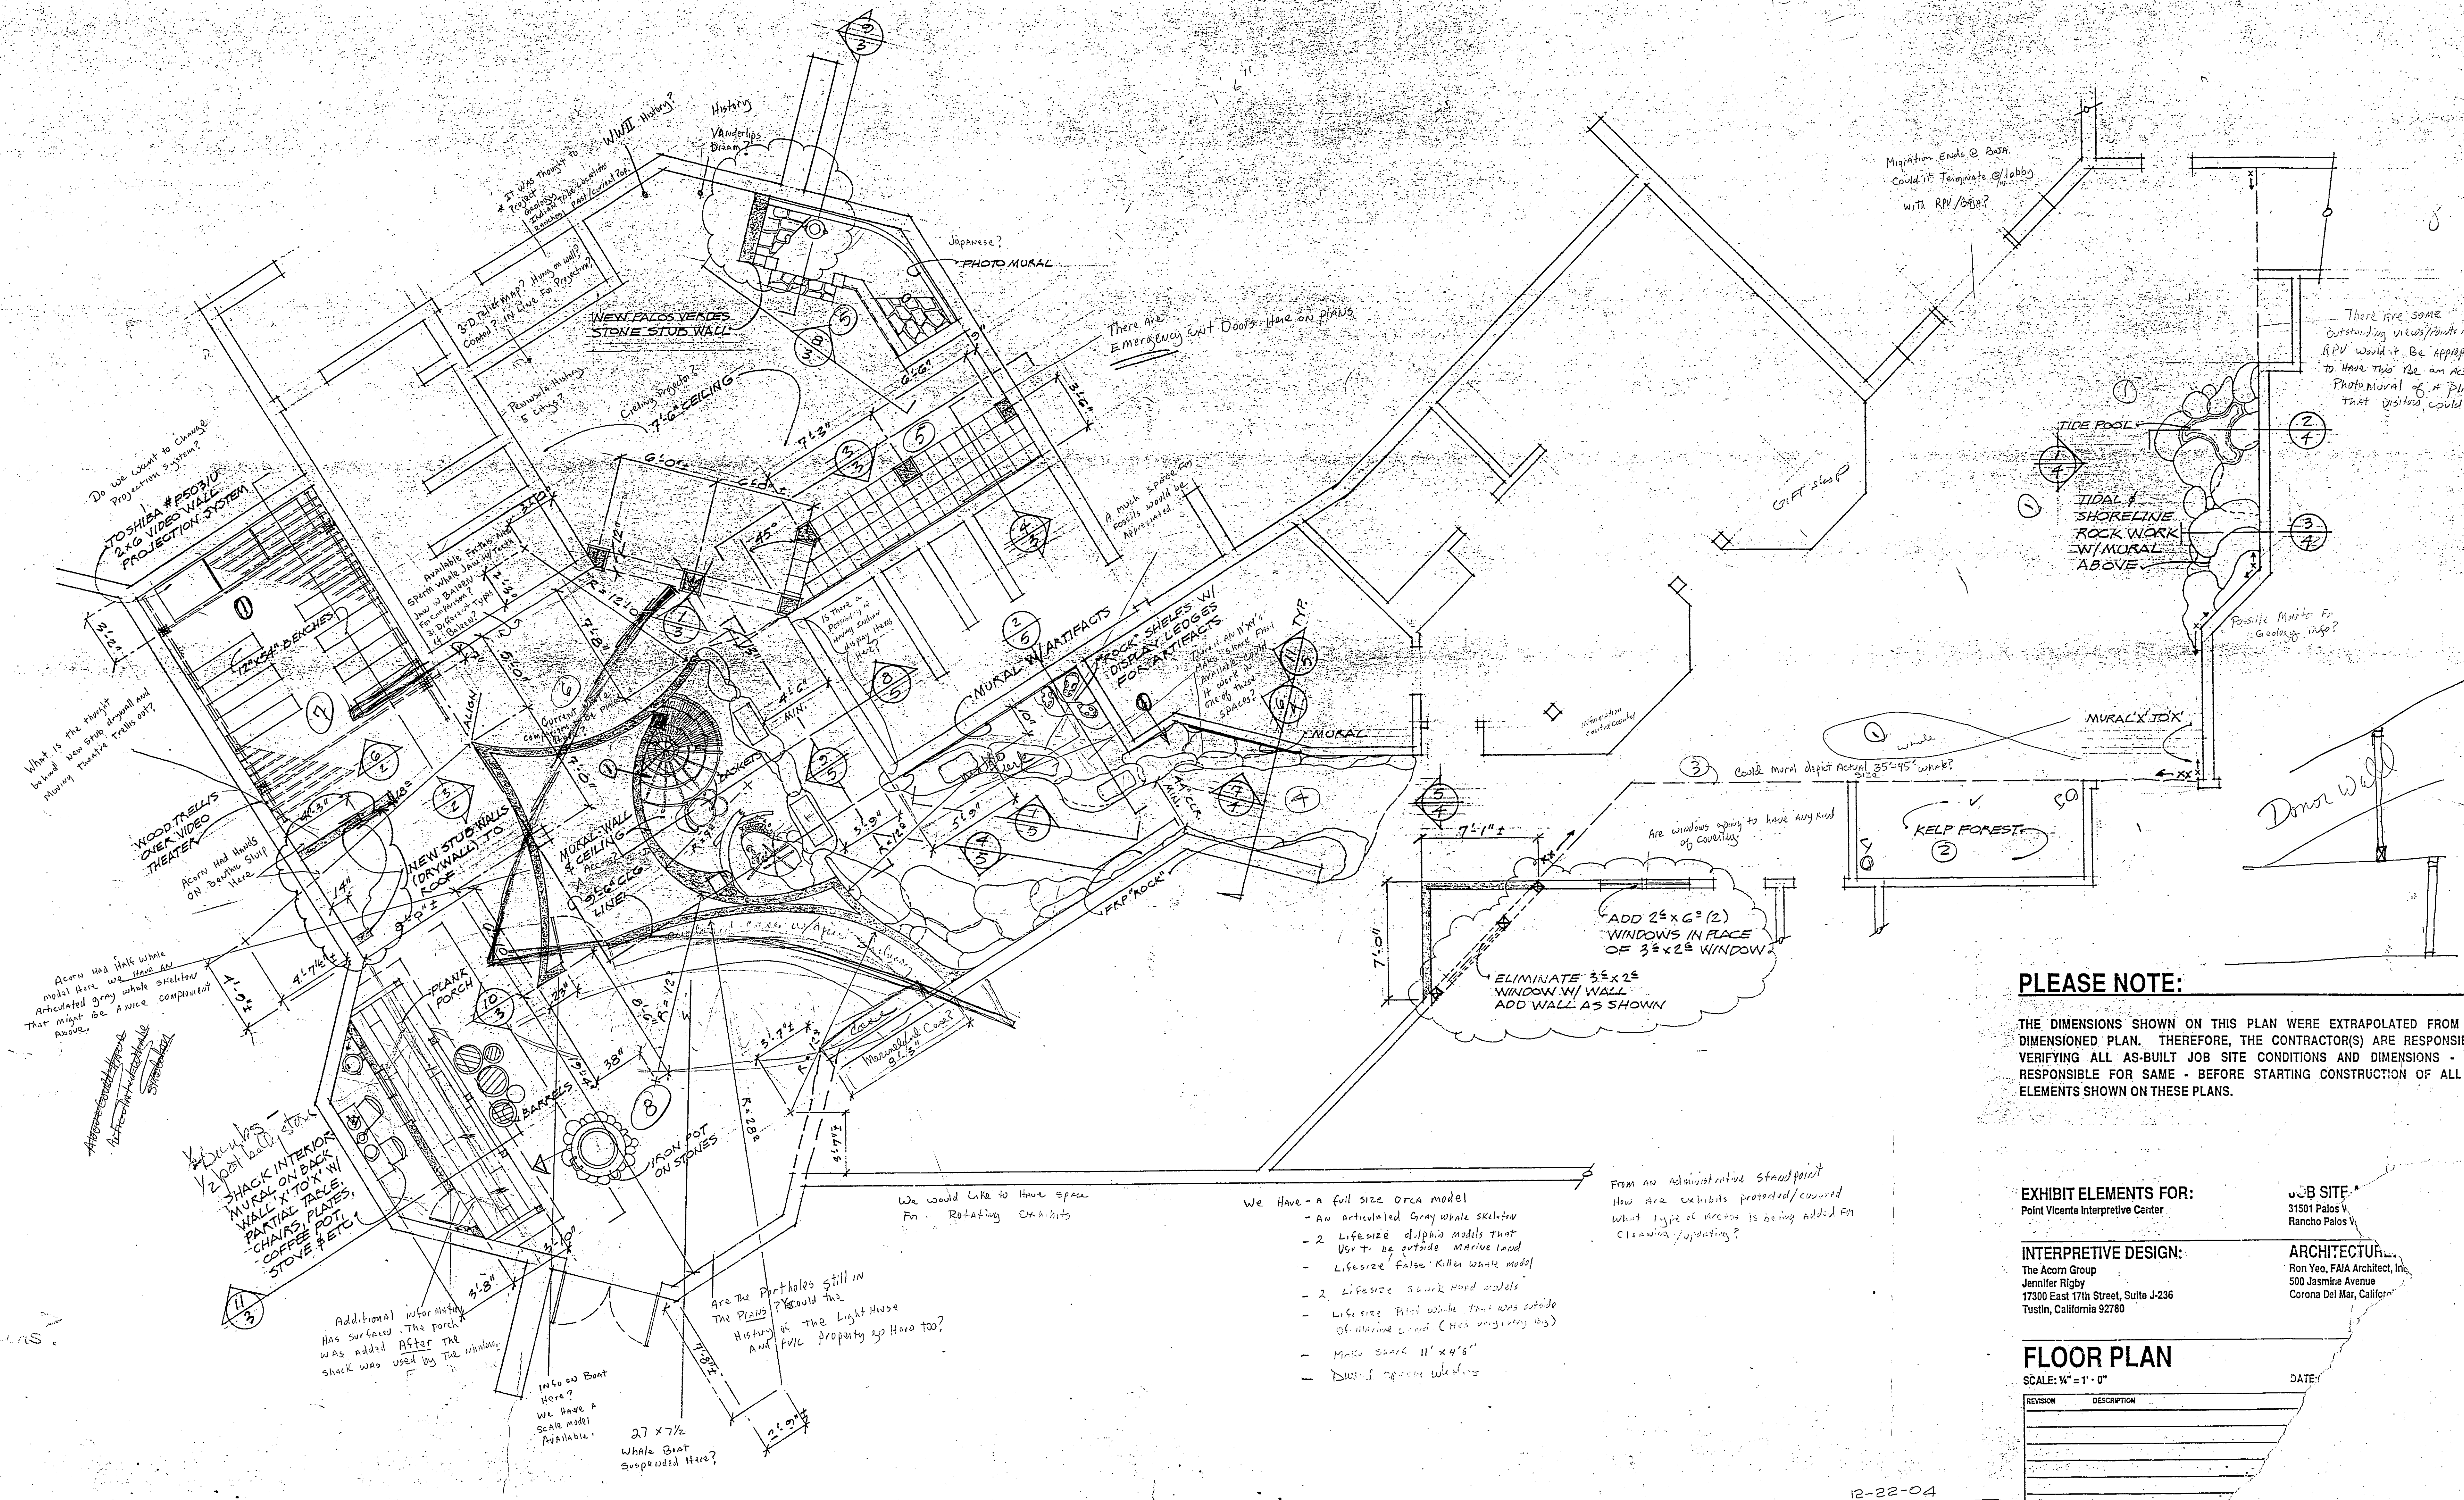

PLEASE NOTE:
 THE DIMENSIONS SHOWN ON THIS PLAN WERE EXTRAPOLATED FROM A NON-DIMENSIONED PLAN. THEREFORE, THE CONTRACTOR(S) ARE RESPONSIBLE FOR VERIFYING ALL AS-BUILT JOB SITE CONDITIONS AND DIMENSIONS - AND BE RESPONSIBLE FOR SAME - BEFORE STARTING CONSTRUCTION OF ALL EXHIBIT ELEMENTS SHOWN ON THESE PLANS.

EXHIBIT ELEMENTS FOR:
 Point Vicente Interpretive Center

JOB SITE:
 31501 Palos Verdes
 Rancho Palos Verdes, CA

INTERPRETIVE DESIGN:
 The Acorn Group
 Jennifer Rigby
 17300 East 17th Street, Suite J-236
 Tustin, California 92780

ARCHITECTURAL:
 Ron Yeo, FAIA Architect, Inc.
 500 Jasmine Avenue
 Corona Del Mar, California 92625

FLOOR PLAN
 SCALE: 1/8" = 1'-0" DATE: _____

REVISION	DESCRIPTION

12-22-04