


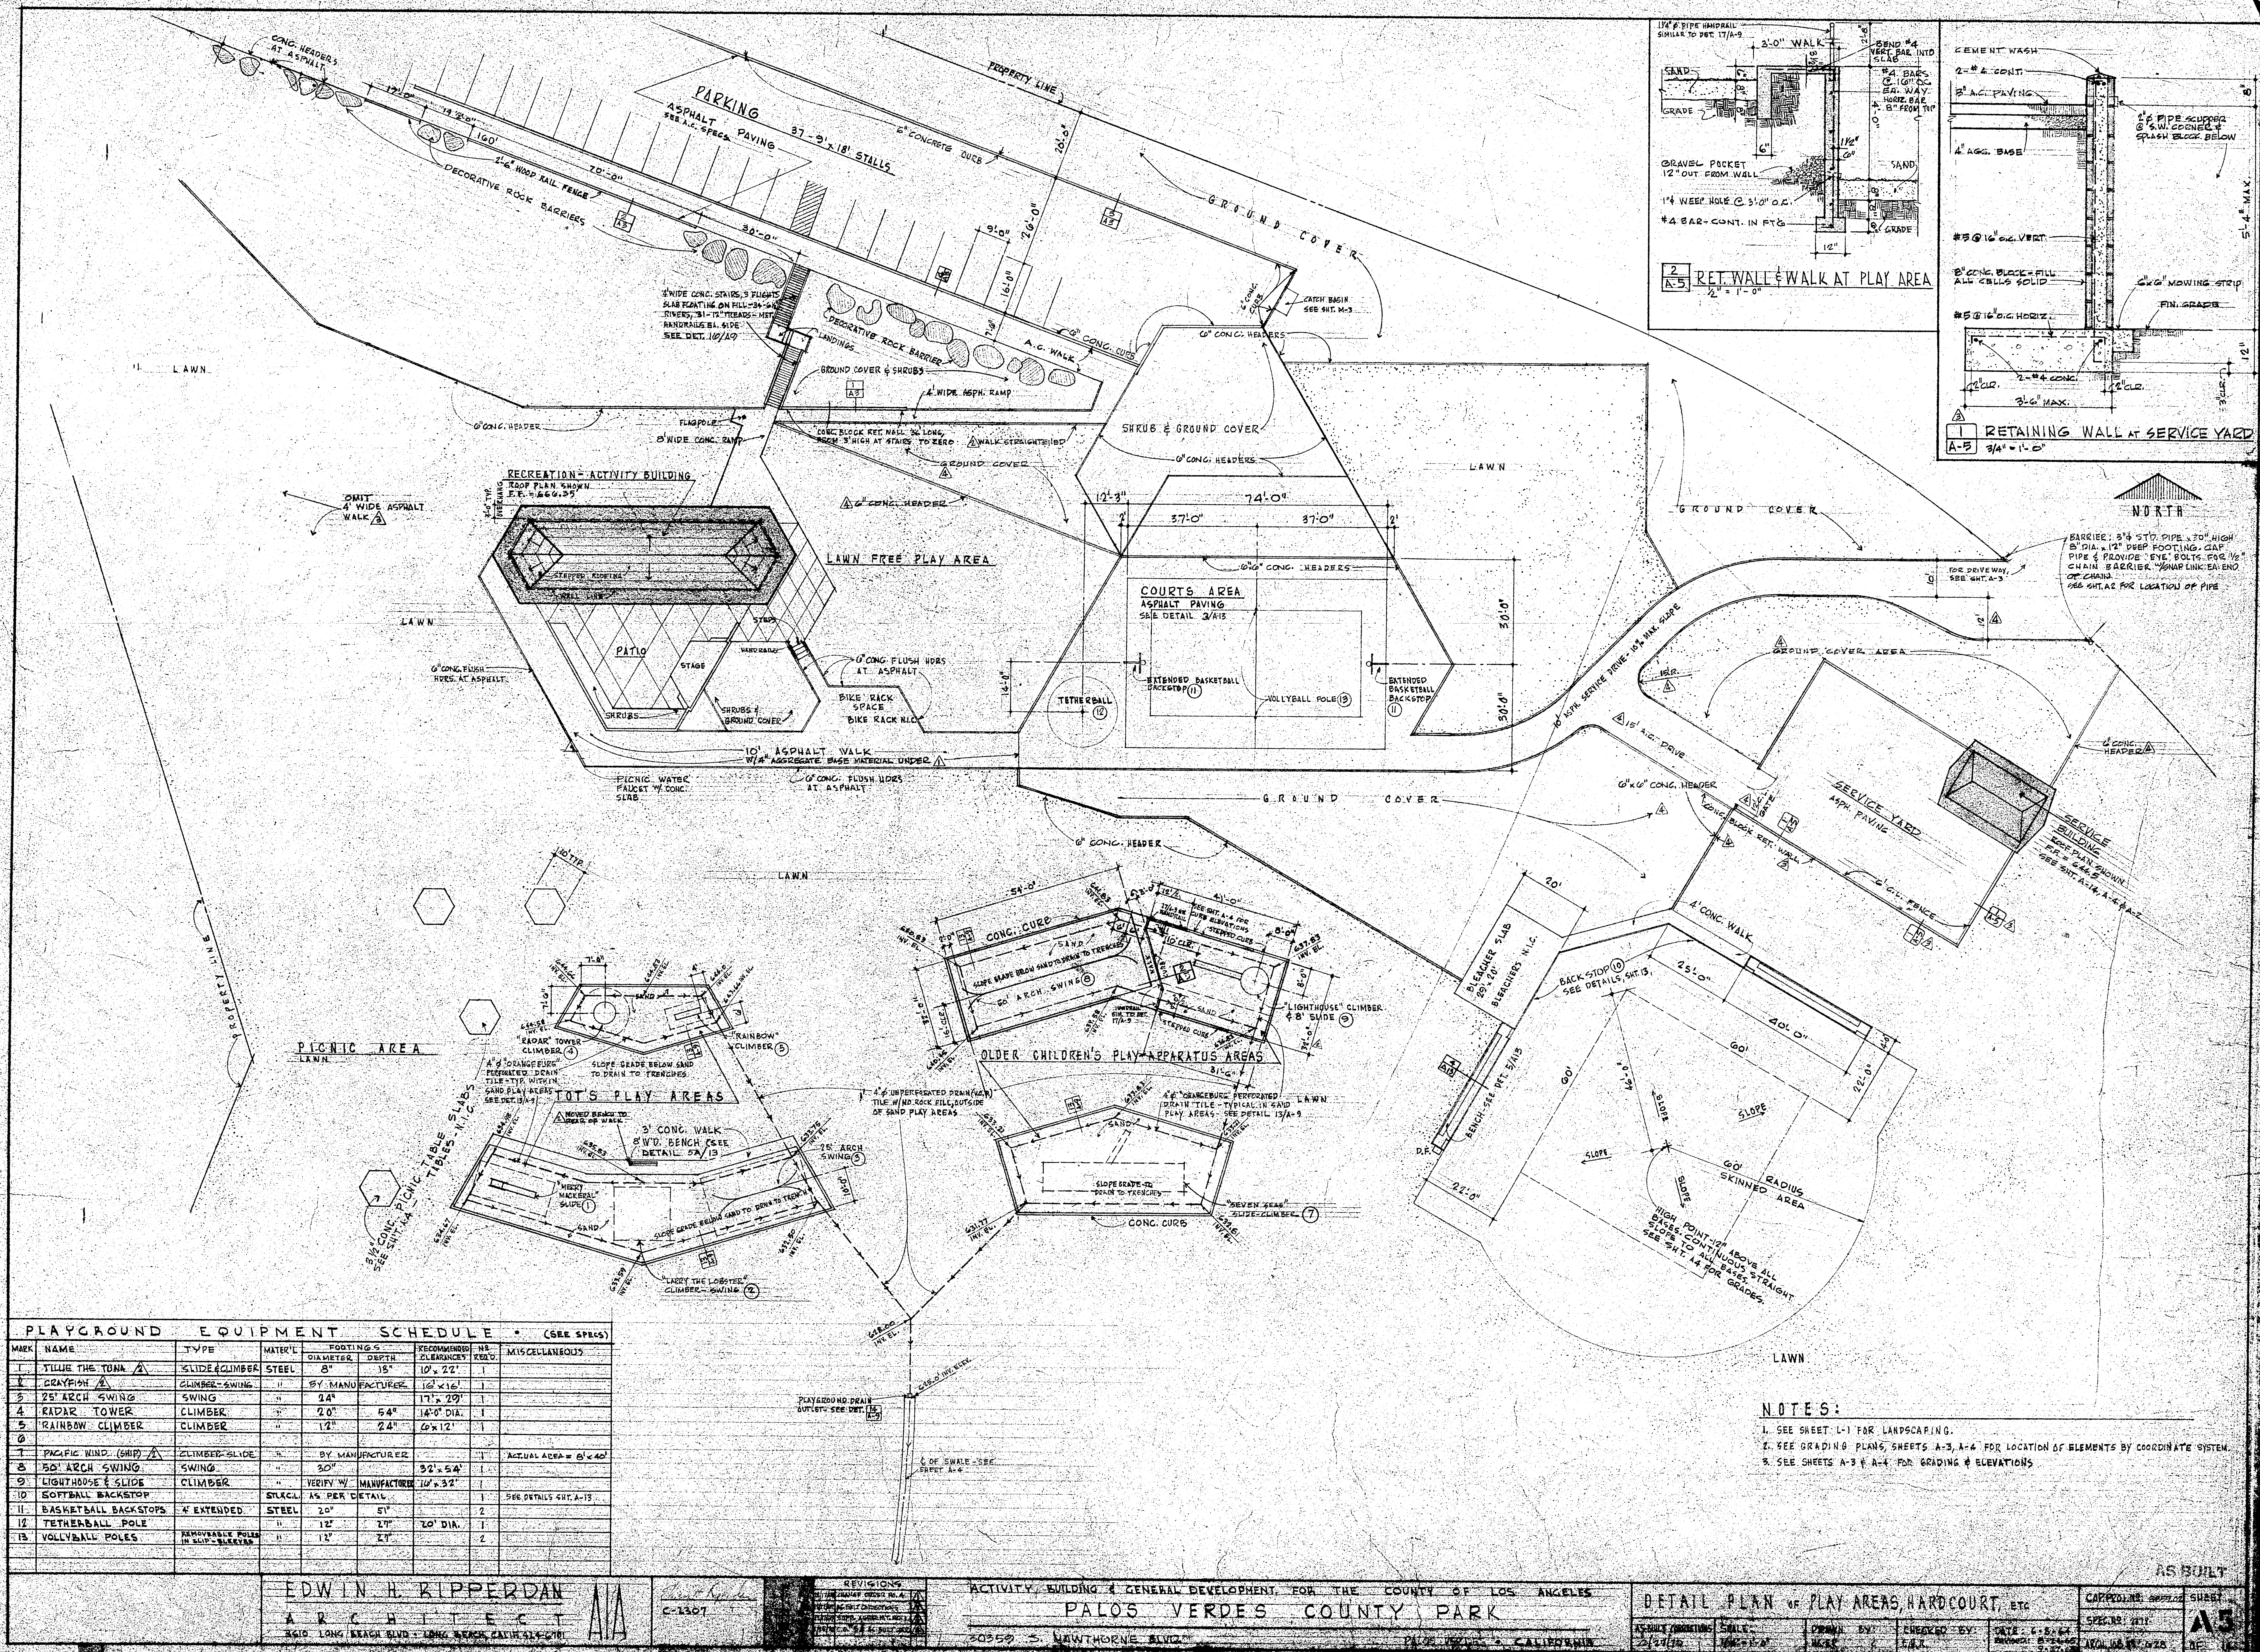

PLAYGROUND EQUIPMENT SCHEDULE - (SEE SPECS)									
MARK	NAME	TYPE	MATERIAL	FOOTINGS	RECOMMENDED CLEARANCES	REMARKS	NO.	REMARKS	MISCELLANEOUS
1	TWINE THE TONK	SLIDE & CLIMBER	STEEL	8" DIA. X 18"	10' X 22'		1		
2	CRAYFISH	CLIMBER-SWING	"	BY MANUFACTURER	16' X 16'		1		
3	25' ARCH SWING	SWING	"	24"	17' X 29'		1		
4	RADAR TOWER	CLIMBER	"	20"	54"	14'0" DIA.	1		
5	RAINBOW CLIMBER	CLIMBER	"	12"	24"	6' X 12'	1		
6	PACIFIC WIND (SHIP)	CLIMBER-SLIDE	"	BY MANUFACTURER			1		
7	50' ARCH SWING	SWING	"	30"	32' X 54'		1		
8	LIGHTHOUSE & SLIDE	CLIMBER	"	VERIFY W/ MANUFACTURER	10' X 32'		1		
9	SOFTBALL BACKSTOP	STRUCT.	AS PER DETAIL				1		SEE DETAILS SHT. A-13
10	BASKETBALL BACKSTOPS	4' EXTENDED	STEEL	20"	51"		2		
11	TETHERBALL POLE	REMOVABLE POLE IN SLIP-SLEEVE	"	12"	27"	20" DIA.	1		
12	VOLLEYBALL POLES		"	12"	27"		2		

NOTES:
1. SEE SHEET L-1 FOR LANDSCAPING.
2. SEE GRADING PLANS, SHEETS A-3, A-4 FOR LOCATION OF ELEMENTS BY COORDINATE SYSTEM.
3. SEE SHEETS A-3 & A-4 FOR GRADING & ELEVATIONS.

EDWIN H. RIPPERDAN
ARCHITECT
2010 LONG BEACH BLVD. LONG BEACH, CALIF. 90801

REVISIONS
C-1307

ACTIVITY BUILDING & GENERAL DEVELOPMENT FOR THE COUNTY OF LOS ANGELES
PALOS VERDES COUNTY PARK
20355 S. NANTHORNE BLVD. PALM BEACH, CALIFORNIA

DETAIL PLAN OF PLAY AREAS, HARD COURT, ETC.
AS BUILT
SHEET #5