


NEW GAS LINE READ: ACROSS HAWTHORNE BLVD TO METER DISTANCE 496' 1"

CHAIN LINK ENCLOSURE FOR GAS METER. FURNISH CHAIN LINK SIDES & TOP & PROVIDE NECESSARY GATE & CONC. WORK. FENCE 3'-6" x 8'-0"

GAS USE

HEATING - 120 CFH
 COOKING - 75 CFH
 HOT WATER - 27 CFH

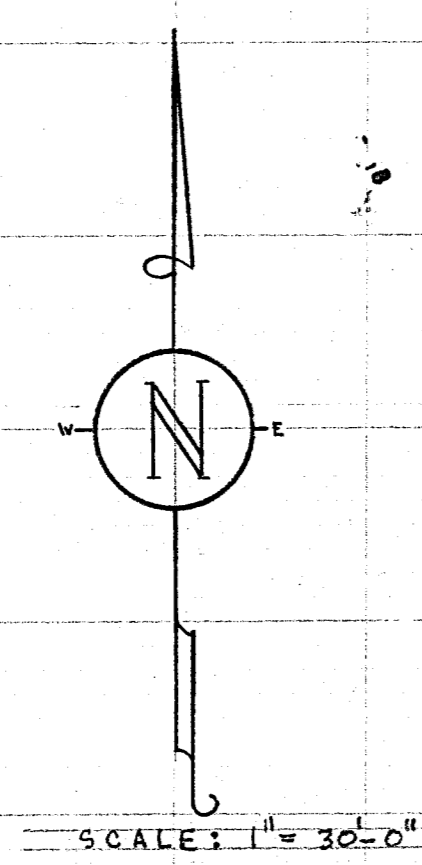

SCANNED

SCANNED

EXISTING 12" TRANSITE WATER MAIN - 75 PSIG AT ELEV. 675

720 F.G.

4" WATER METER 225 STM
 4" SUB. OUT & VALVE OFF FOR SPRINKLER SYSTEM

RECREATION ACTIVITY BLDG.

PICNIC WATER FOUNTAIN WITH SEEPAGE PIT AS PER L.A. COUNTY STD. LG-10-R-1

SOFTBALL FIELD

HAWTHORNE BLVD.

SEE MECH. SHEET NO. M-2 FOR DRAIN & SEWER LAYOUT

EXISTING 15" SEWER

EXISTING M.H.

EXISTING CURB

PROP. LINE

NEW 4" DIA. COPPER GALV. STEEL DRAIN PIPE

SEE SHEET M-2

620 F.G.

610 N.G.

620 F.G.

610 F.G.

620 F.G.

610 F.G.

J. G. McDONALD
 MECHANICAL ENGINEER
 LONG BEACH CALIFORNIA

EDWIN H. RIPPERDAN
 ARCHITECT
 3610 LONG BEACH BLVD. LONG BEACH, CALIF. CA 46701

C-2307

REVISIONS
1. REVISE DRAIN LAYOUT
2. REVISE SEWER LAYOUT
3. REVISE SEWER LAYOUT

ACTIVITY BUILDING & GENERAL DEVELOPMENT FOR THE COUNTY OF LOS ANGELES
 PALOS VERDES COUNTY PARK
 30359 S. HAWTHORNE BLVD. PALOS VERDES • CALIF.

MECHANICAL PLOT PLAN		CAP. PROJ. NO. 209702 SHEET	
AS-BUILT CORRECTIONS	SCALE: 1" = 30'-0"	DATE: 6-8-64	SPEC. NO. 2379
2/2/70		REVISED: 1-25-65	ARCH. JOB NO. 628
		REVISED: 3-27-65	OF 3
		REVISED: 11-16-65	
DRAWN BY: J.G.M., E.H.R.	CHECKED BY: E.H.R.		

AS BUILT

M2P