
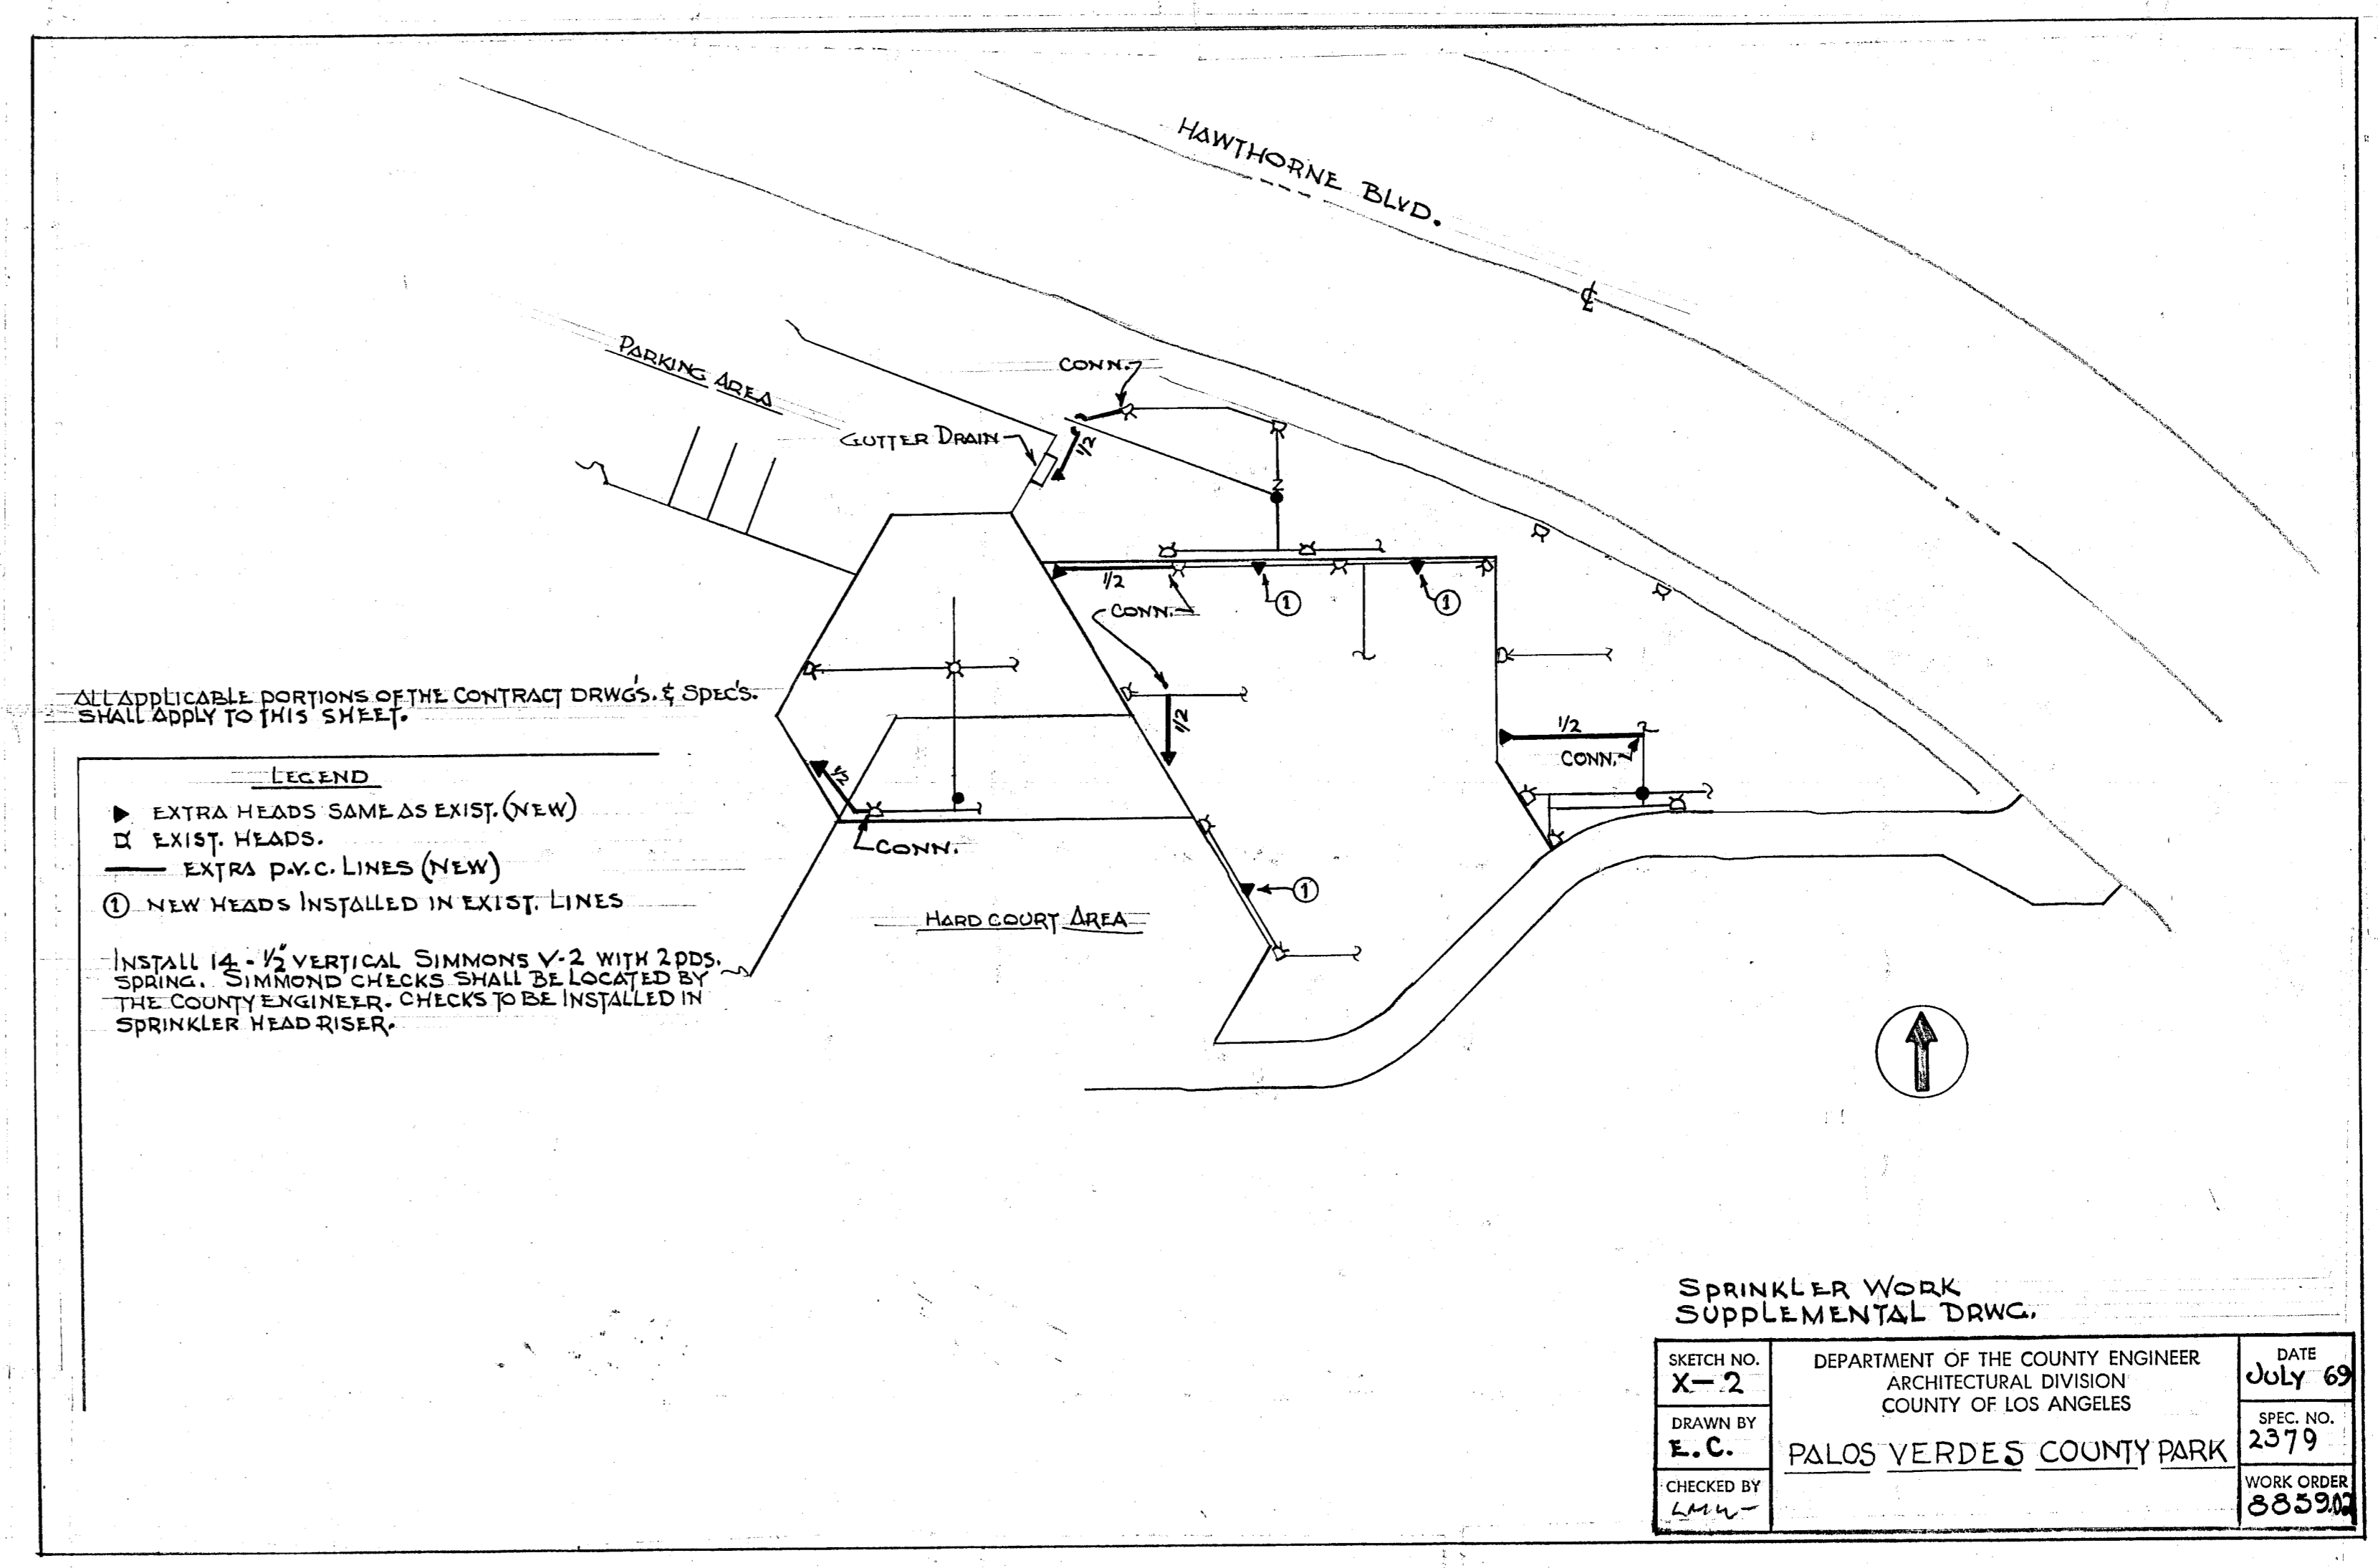


EASI FILE CORP. IRVINE, CA
 HANSEN EHRD
 120
 RPI Back
 Supplemental Drawings
 Sprinkler Work
 Sheet X-1 & X-2

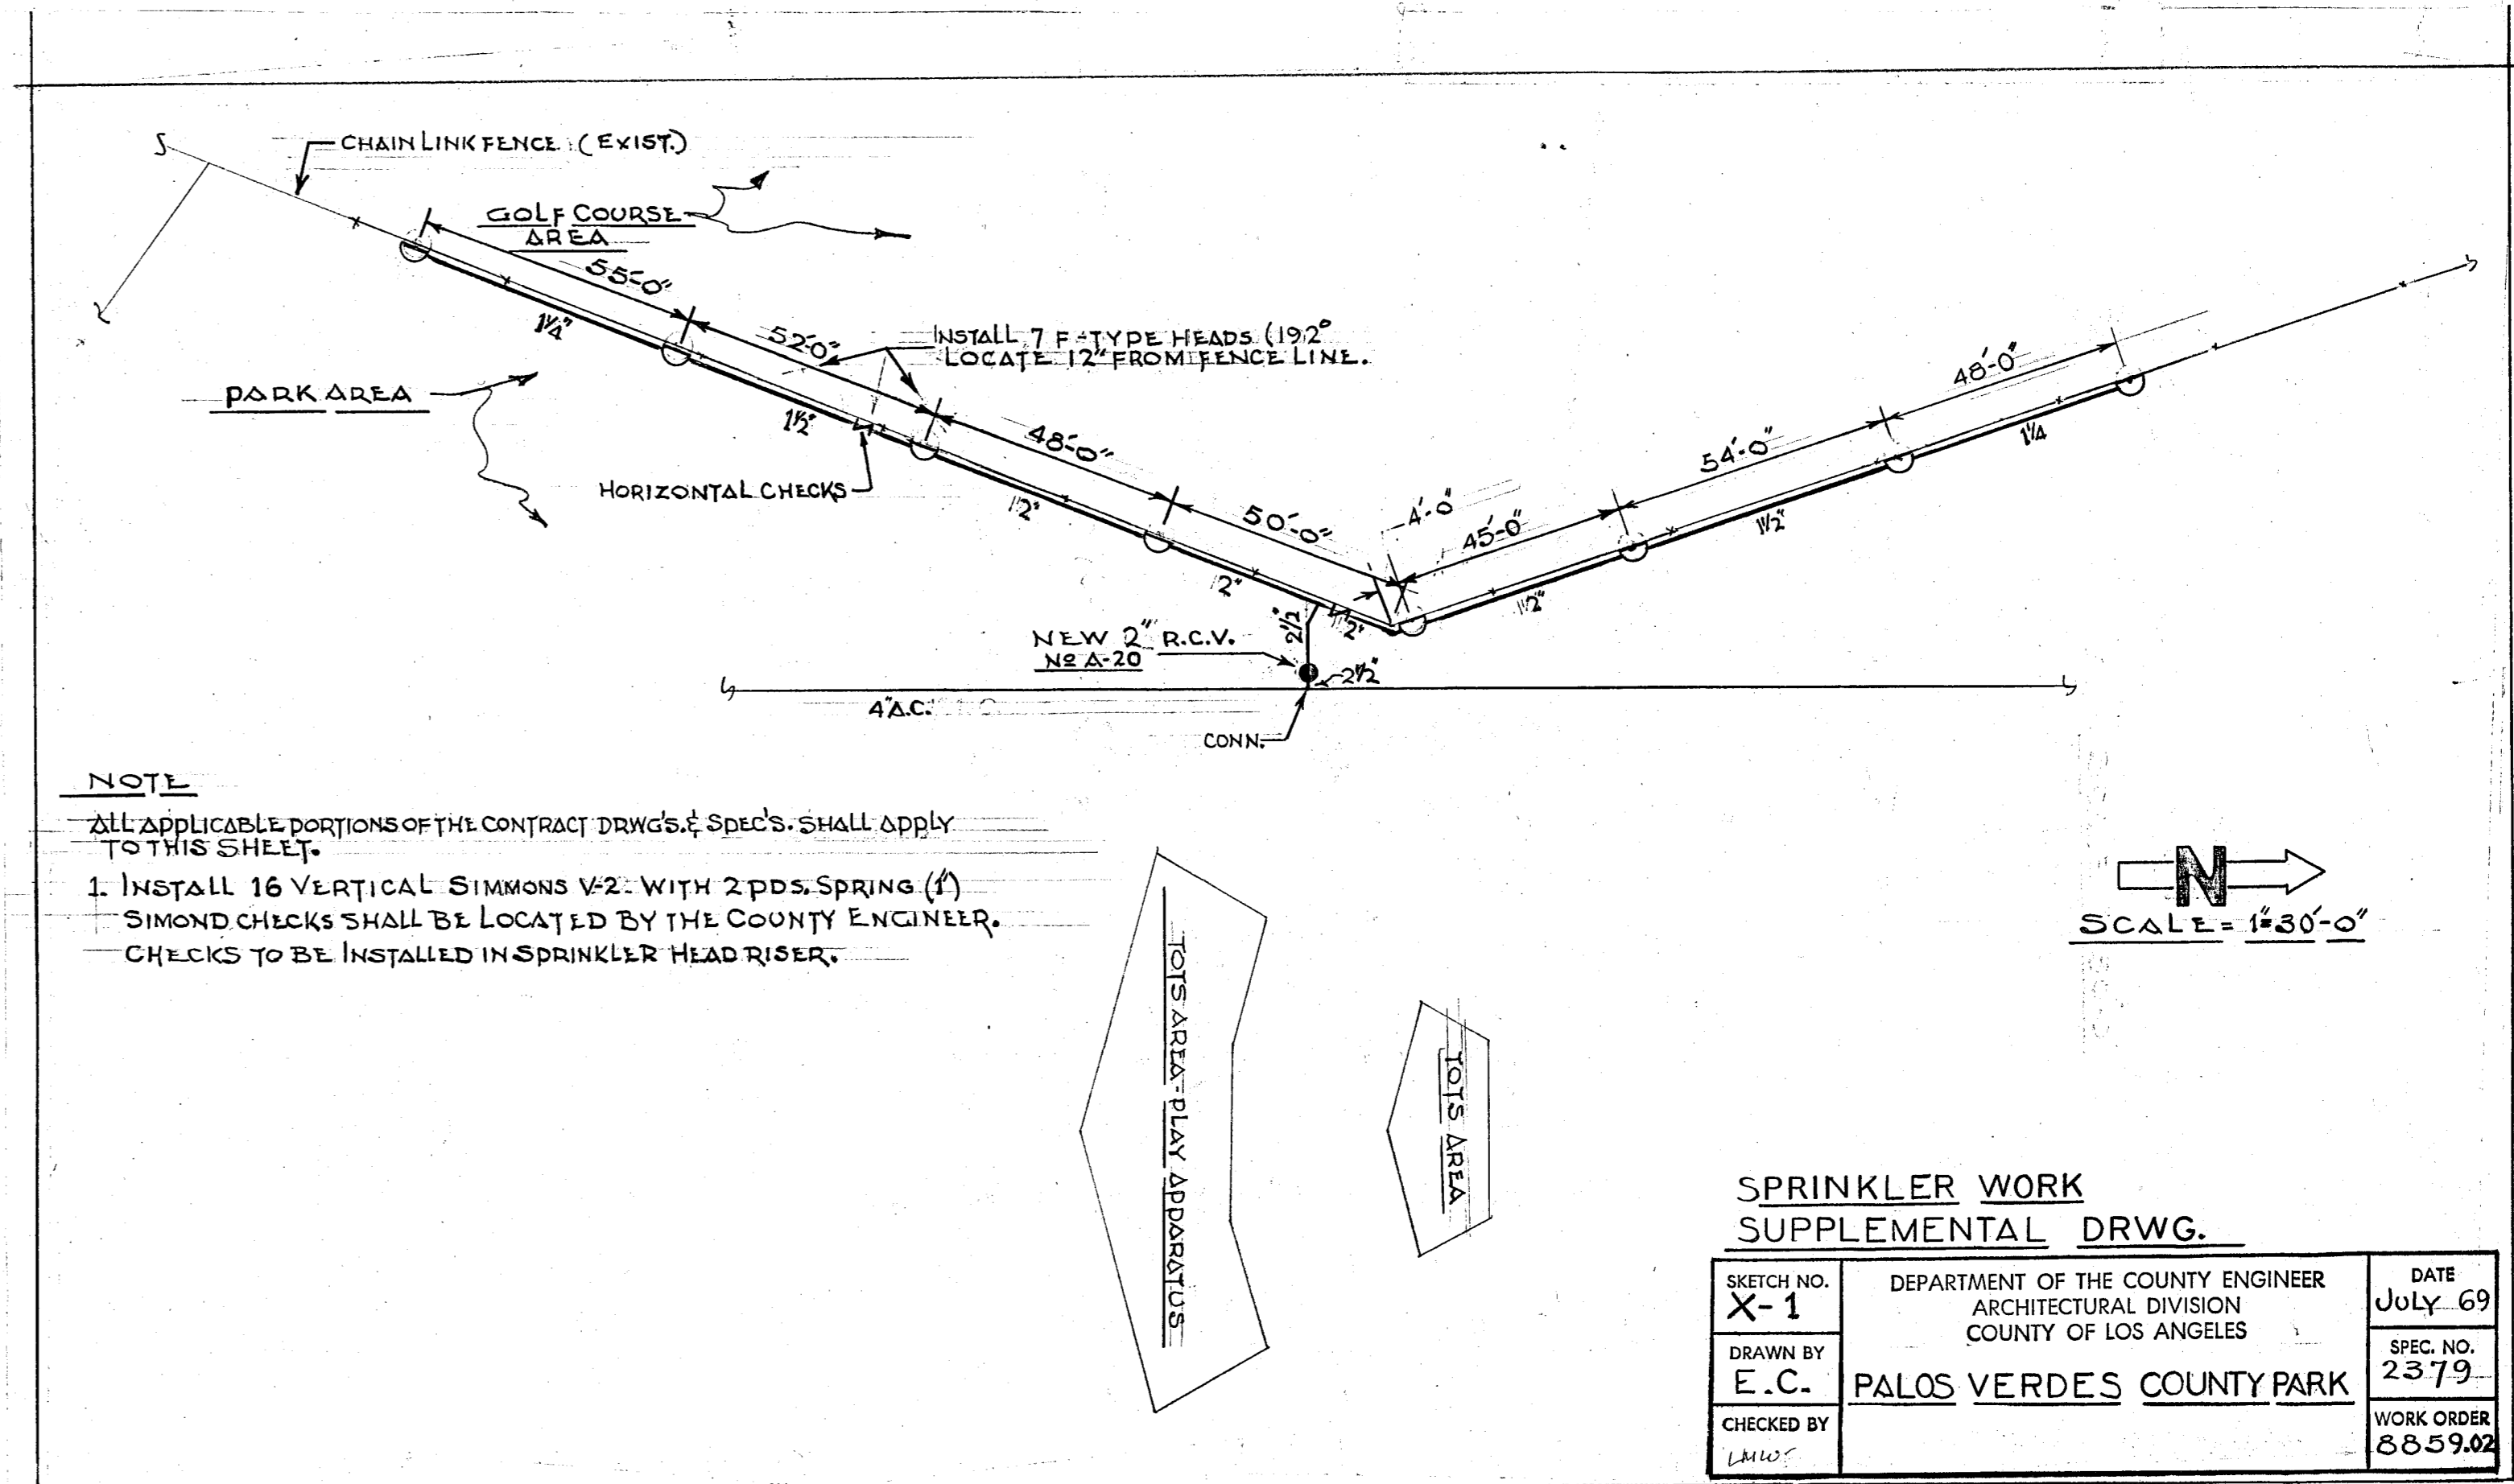

AS BUILT

SHEET No.
X-1 & X-2

SUPPLEMENTAL DRAWINGS

NOTE: CONTRACTOR SHALL VERIFY AND BE RESPONSIBLE