


LEGEND

- - VALVE & BOX
- - HEAD
- X - TYPE A HEAD
- ⊗ - GATE VALVE
- ⊠ - VALVE SEQUENCE
- ⊡ - TYPE OF HEAD
- - MAINLINE

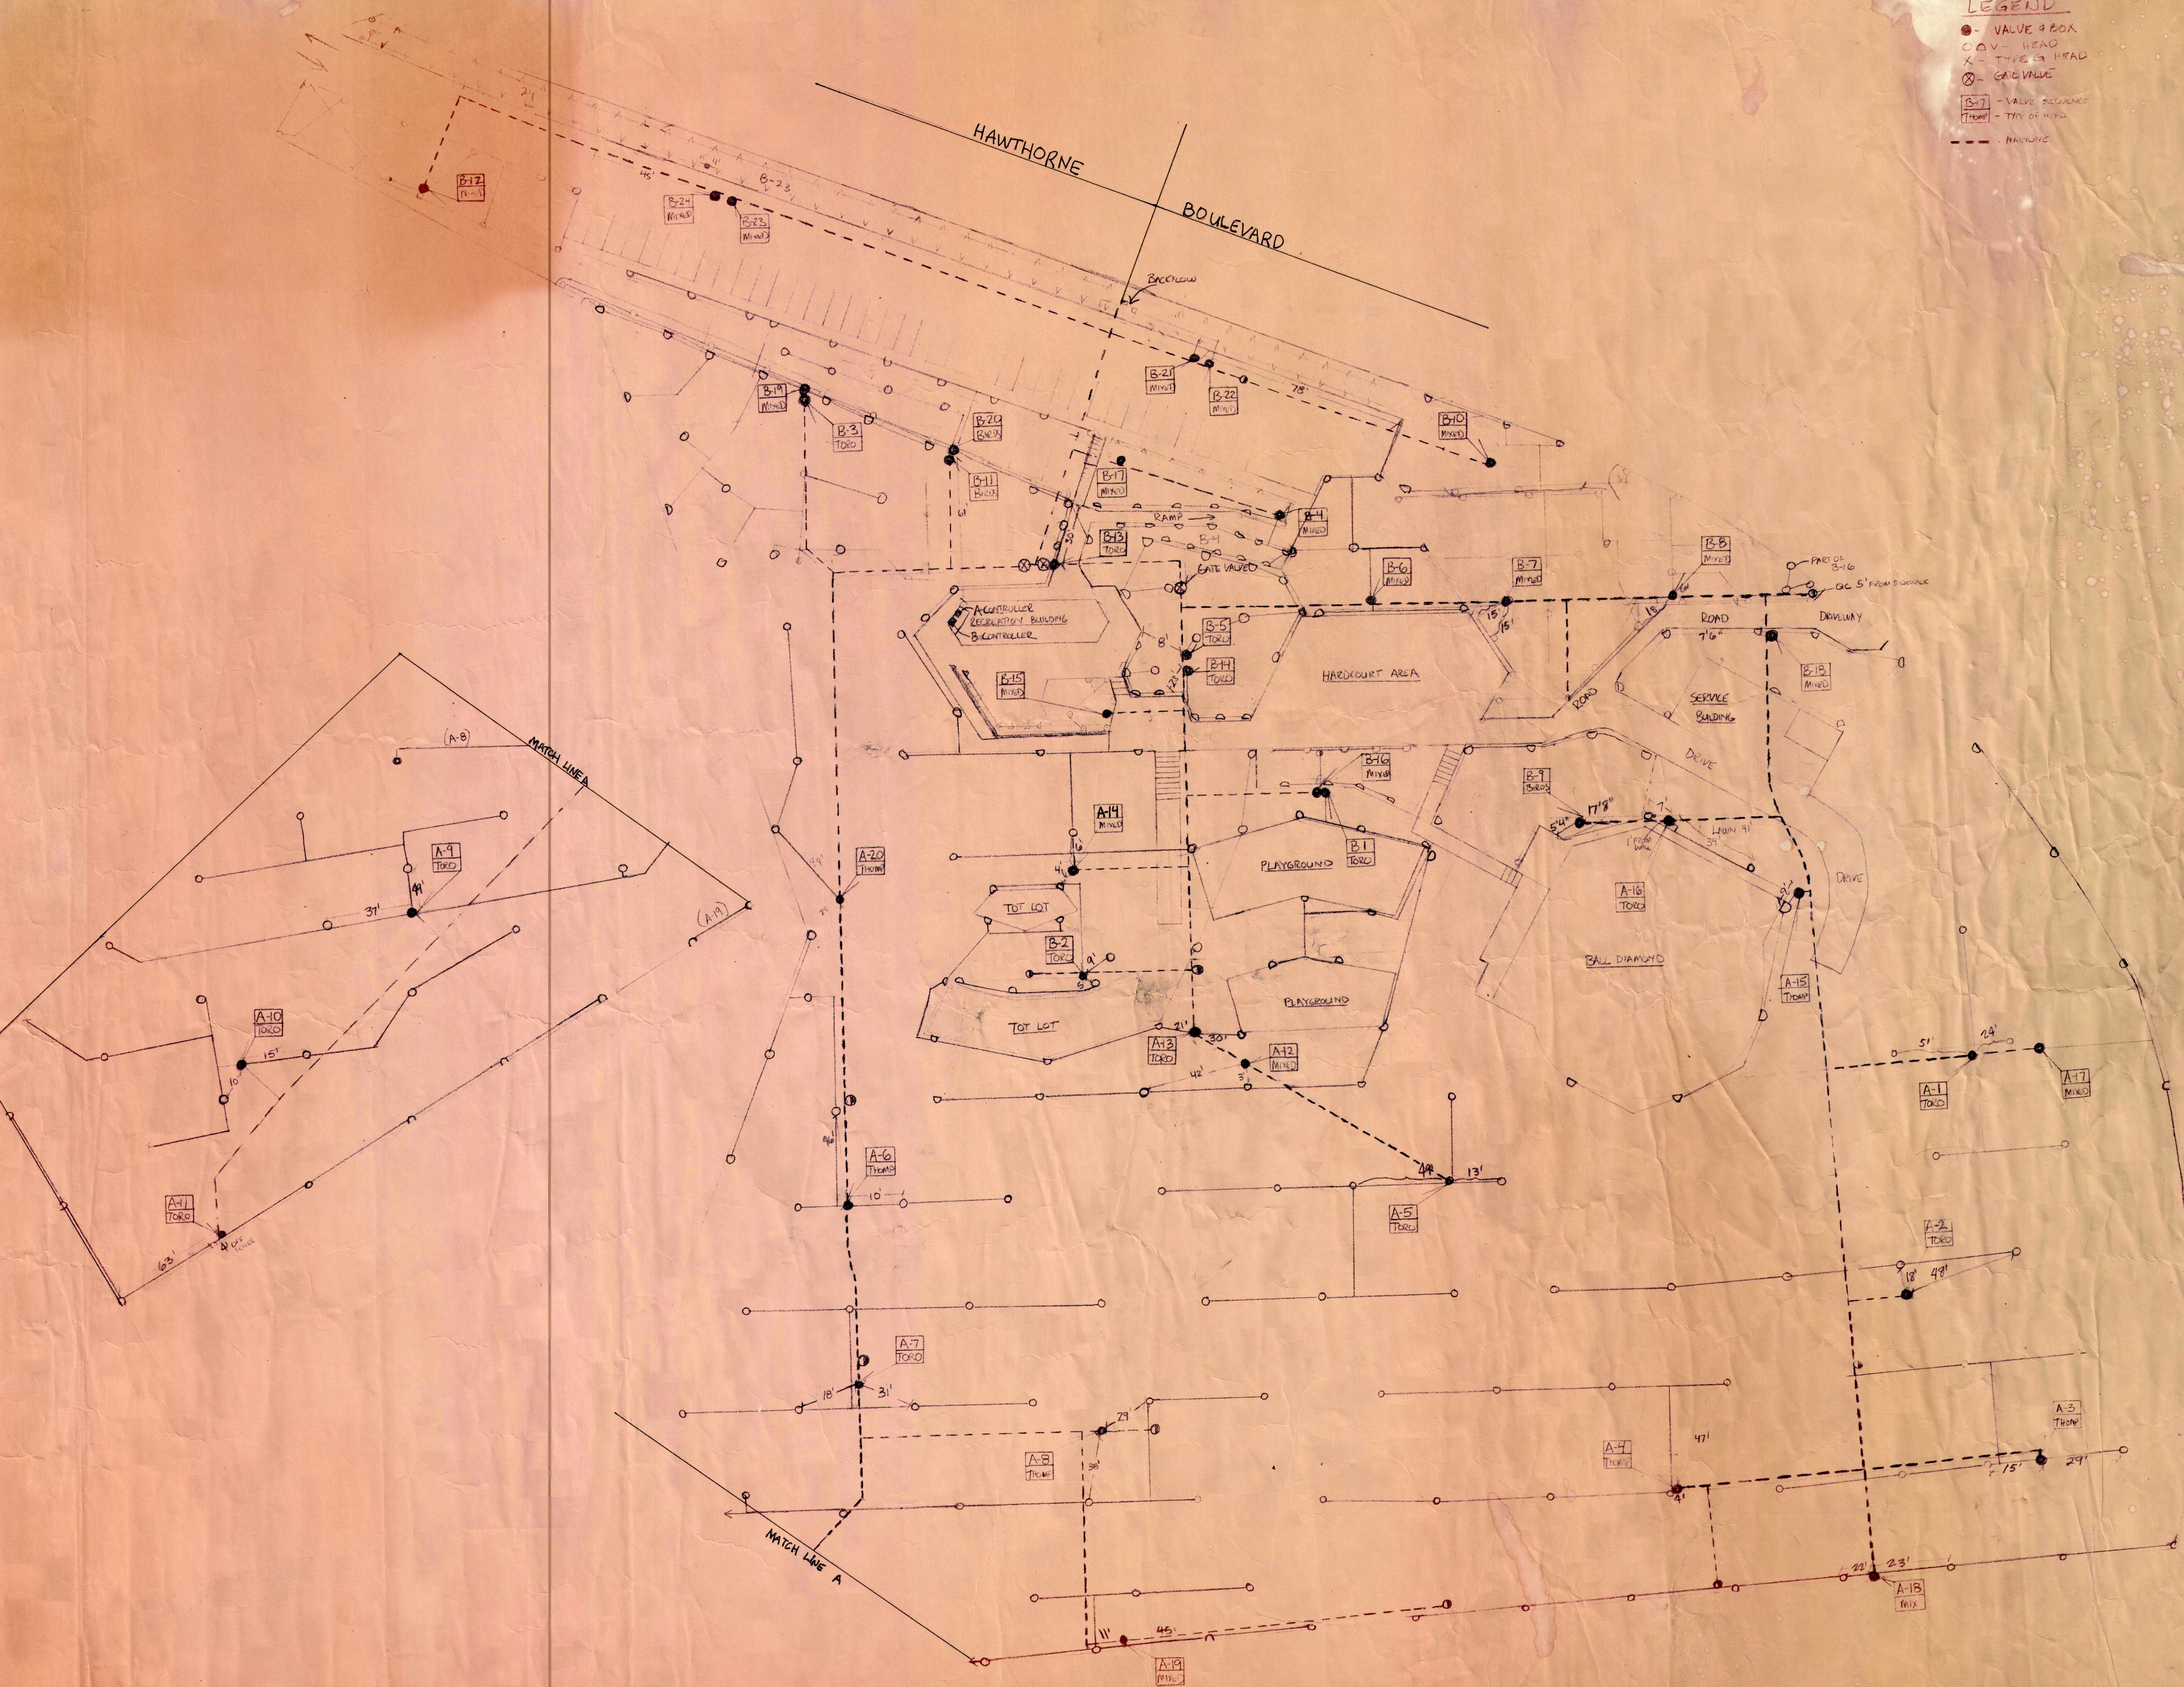

RANCHO PALOS VERDES PARK

AS-BUILT IRRIGATION PLAN

AS-BUILT DRAWING SCALE: 1"=30'

DRAWN BY: G. BLACKBURN
CHECK BY: